

Marion
 N 2013
 4/76

MISSISSIPPI
 BOARD OF WATER COMMISSIONERS
 416 North State Street
 Jackson, Mississippi 39201

WATER WELL DRILLERS LOG

April 1976 E.B. Sheppard & Marion
 Date well completed firm name county well located


LANDOWNER:	description of formations encountered	from	to
Vernon Holmes Forworth, Ms. (mailing address)	RED SANDY & LARGE GR.	0	90'
WELL LOCATION: sec 8 T 20 N R 13 E S W 6 miles SW of Forworth (distance) (direction) (nearest town)			
WELL PURPOSE: (home, irrigation, municipal, industrial)			
WELL COMPLETION DATA:			
(1) diameter (inches) 2"			
(2) total depth (feet) 90'			
(3) static water level (feet) 50' below top of ground.			
(4) casing (material) pl. (depth) 85'			
2" (size) If telescope see back.			
(5) screen (length) 5' (depth to top)			
2" (size) pl. (material)			
(6) pump (HP) 1 (yield gpm) 8			
elec. (type power)			
(7) electric log (yes or no)			
(organization running log)			
(8) how well bottom plugged BWW			
DRILLERS REMARKS:			

RECEIVED
 OCT 18 1976

MISS. BD. OF WATER COMM

If well telescopes please sketch and show depths.

GROUND LEVEL

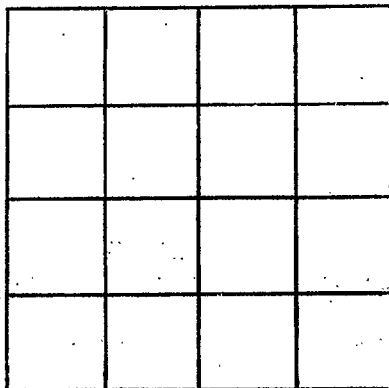

SECTION _____

Please indicate well location X.

ADDITIONAL INFORMATION

If more than one screen, show locations of each on sketch.