

Marion
 N 2014
 May 76

MISSISSIPPI
 BOARD OF WATER COMMISSIONERS
 416 North State Street
 Jackson, Mississippi 39201

WATER WELL DRILLERS LOG

May 1976 E.B. Sherrard, Marion
 date well completed firm name county well located

LANDOWNER:

James Hathorn
 Toxworth, Ms.
 (mailing address)

description of formations encountered

from to

SANDY REDDISH CLAY
 SAND & GR.
 0-80'
 80-148'

WELL LOCATION:

sec. 1 T 20 N R 12 E
 6 miles SW of Toxworth
 (distance) (direction) (nearest town)

WELL PURPOSE:

(home, irrigation, municipal, industrial)

WELL COMPLETION DATA:

- (1) diameter (inches) 2"
- (2) total depth (feet) 148'
- (3) static water level (feet) 115' below top of ground.
- (4) casing (material) pl. (depth) 143'
- 2" If telescope see back. (size)
- (5) screen 5' (length) (depth to top)
- 2" pl. (size) (material)
- (6) pump 1/2 (HP) 7 (yield gpm)
- elec. (type power)
- (7) electric log (yes or no)

(organization running log)


(8) how well bottom plugged B.W.V.

DRILLERS REMARKS:

RECEIVED
 OCT 18 1976

If well telescopes please sketch and show depths.

GROUND LEVEL

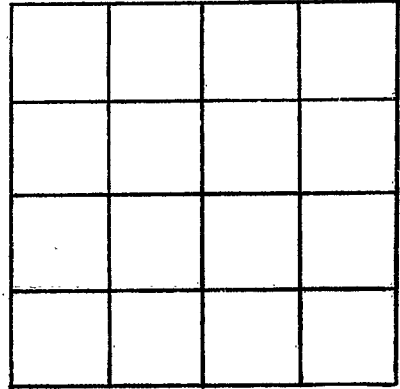

SECTION _____

Please indicate well location X.

ADDITIONAL INFORMATION

If more than one screen,
show locations of each on sketch.