

MARION  
 N 2015  
 8-9-76

MISSISSIPPI  
 BOARD OF WATER COMMISSIONERS  
 416 North State Street  
 Jackson, Mississippi 39201

WATER WELL DRILLERS LOG

8-9 1976 Hollinsek Plumb. Marion  
 date well completed firm name county well located

LANDOWNER: Dennis Russell	description of formations encountered	from	to
Rt 2 Box 215			
Forworth Miss. (mailing address)	clay gravel chert clay sand	0 40 100	40 100 140
WELL LOCATION: 13E sec. 21 T. 2 N R. 19 E 4 miles W of Cheraw (distance) (direction) (nearest town)			
WELL PURPOSE: Home (home, irrigation, municipal, industrial)			
WELL COMPLETION DATA:			
(1) diameter (inches) 2			
(2) total depth (feet) 140			
(3) static water level (feet) 100 below top of ground.			
(4) casing PVC 140 (material) (depth)			
if telescope see back. (size)			
(5) screen 5 135 (length) (depth to top)			
2 PVC (size) (material)			
(6) pump 1 1/2 8 (HP) (yield gpm)			
elect. (type power)			
(7) electric log (yes or no)			
(organization running log)			
(8) how well bottom plugged sand sharps			
DRILLERS REMARKS: good well			


RECEIVED

SEP 13 1976

MISS. BD. OF WATER COMMISSIONERS

If well telescopes please sketch and show depths.

GROUND LEVEL

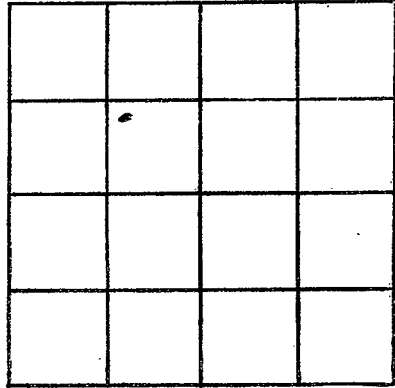

SECTION 21

Please indicate well location X.

ADDITIONAL INFORMATION

If more than one screen,  
show locations of each on sketch.