

MARION  
 N 2016  
 9/6/77

MISSISSIPPI  
 BOARD OF WATER COMMISSIONERS  
 416 North State Street  
 Jackson, Mississippi 39201

WATER WELL DRILLERS LOG

Keith Reynolds 134 77 Hollingsworth Plumb. Marion  
 date well completed firm name county well located

LANDOWNER: Keith Reynolds	description of formations encountered	from	to
RT 2			
Foxworth, Miss. (mailing address)	CLAY gravel	0	50
	CLAY	50	70
	SAND, gravel	70	127

WELL LOCATION:  
 sec. 1 T. 2(N) S. R. 2(E) E.  
 9 miles 3 W. of Foxworth  
 (distance) (direction) (nearest town)

WELL PURPOSE: Home  
 (home, irrigation, municipal, industrial)

WELL COMPLETION DATA:

(1) diameter (inches) 2

(2) total depth (feet) 127

(3) static water level (feet) 70 below above top of ground.

(4) casing PVC, 117 (material) (depth)  
 (size) if telescope see back.

(5) screen 10, 117 (length) (depth to top)  
 2, PVC (size) (material)

(6) pump 1 1/2, 9 (HP) (yield gpm)  
 elect (type power)

(7) electric log (yes or no)

(organization running log)

(8) how well bottom plugged SAND  
 SHARK


DRILLERS REMARKS: good  
 1 well

RECEIVED

SEP 13 1977

If well telescopes please sketch and show depths.

GROUND LEVEL

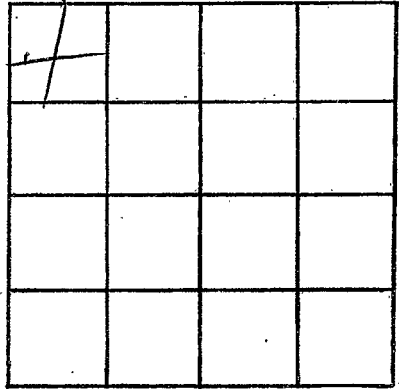

SECTION 1

Please indicate well location X.

ADDITIONAL INFORMATION

If more than one screen, show locations of each on sketch.