

Marion
 N 2017
 5/5/77

MISSISSIPPI
 BOARD OF WATER COMMISSIONERS
 416 North State Street
 13V Jackson, Mississippi 39201

WATER WELL DRILLERS LOG

5/5/77 19 77 Hollinger Pub. Well Serv. Marion
 date well completed firm name county well located

LANDOWNER: Ed Beets, Jr.
 917 Sunset Circle
 Columbia, Miss
 (mailing address)

description of formations encountered	from	to
clay sand gravel	0	60
sand & gravel	60	140

WELL LOCATION:
 sec. 11 T-2 N R-20 E
 S
 5 miles W of Cheever
 (distance) (direction) (nearest town)

WELL PURPOSE: Home
 (home, irrigation, municipal, industrial)

WELL COMPLETION DATA:

(1) diameter (inches) 2"
 (2) total depth (feet) 140 ft.
 (3) static water level (feet) _____ below above top of ground.
 (4) casing pvc, 135,
 (material) (depth)
 (size) If telescope see back.
 (5) screen 5, 135
 (length) (depth to top)
 2" pvc
 (size) (material)
 (6) pump 1, 9
 (HP) (yield gpm)
 elect
 (type power)
 (7) electric log _____
 (yes or no)
 (organization running log)
 (8) how well bottom plugged sand
 5 ft. 12


DRILLERS REMARKS: very good well

RECEIVED
 JUN 15 1977

MISS. BD. OF WATER COMMISSIONERS

If well telescopes please sketch and show depths.

GROUND LEVEL

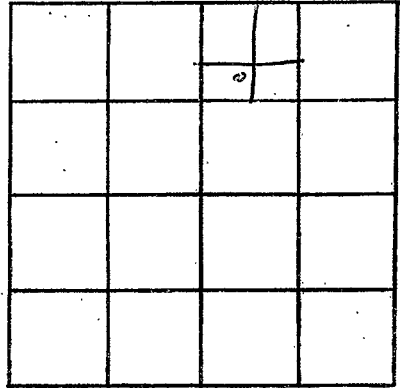

SECTION 11

Please indicate well location X.

ADDITIONAL INFORMATION

If more than one screen,
show locations of each on sketch.