

Marion  
 N 2019  
 5/2/77

MISSISSIPPI  
 BOARD OF WATER COMMISSIONERS  
 416 North State Street  
 13V Jackson, Mississippi 39201

WATER WELL DRILLERS LOG

May-25 19 77 Binn Well Service Marion  
 date well completed firm name county well located

LANDOWNER:  
Mr. Darrell Pounds  
Rt. 2 Jopworth, Miss.  
 (mailing address)

description of formations encountered	from	to
Top Soil	0	1
Clay	1	17
Chalk	17	104
Shale	104	116
Clay	116	125
Sand	125	160

WELL LOCATION:  
 sec 7 T 2 N R 13 E  
106± miles SW of Columbia  
 (distance) (direction) (nearest town)

WELL PURPOSE: Home  
 (home, irrigation, municipal, industrial)


- WELL COMPLETION DATA:
- (1) diameter (inches) 2"
  - (2) total depth (feet) 160 ft.
  - (3) static water level (feet) 60 below above top of ground.
  - (4) casing Plastic, 150 ft.  
 (material) (depth)  
2" If telescope see back.  
 (size)
  - (5) screen 10 ft., 150 ft.  
 (length) (depth to top)  
2", Plastic  
 (size) (material)
  - (6) pump 1 8  
 (HP) (yield gpm)  
Elec  
 (type power)
  - (7) electric log no  
 (yes or no)  
 (organization running log)
  - (8) how well bottom plugged, B.W. Valve

DRILLERS REMARKS:

**RECEIVED**  
 OCT 25 1977  
 MISS. BD. OF WATER COM.

If well telescopes please sketch and show depths.

GROUND LEVEL

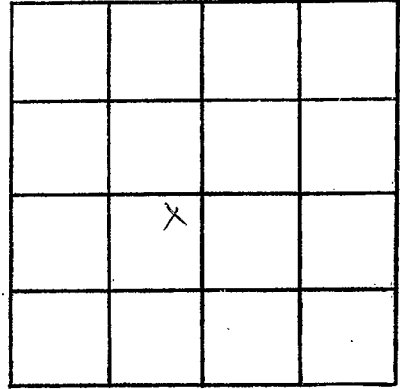

SECTION 9

Please indicate well location X.

ADDITIONAL INFORMATION

Lined area for additional information.

If more than one screen, show locations of each on sketch.