

Marion
 N 2020
 May 6, 1977

MISSISSIPPI
 BOARD OF WATER COMMISSIONERS
 416 North State Street
 Jackson, Mississippi 39201

WATER WELL DRILLERS LOG

May - 6 19 77 Dinn Well Serv. Marion
 date well completed firm name county well located

LANDOWNER:
M. Samuel Echols
Rt. 1 Box 244 - Fopubert
 (mailing address) Miss.

WELL LOCATION:
 sec 23 T 2 N R 13 E
6 miles SW of Salubria
 (distance) (direction) (nearest town)

description of formations encountered	from	to
<u>Top Soil</u>	<u>0</u>	<u>1</u>
<u>Clay</u>	<u>1</u>	<u>16</u>
<u>Clay & gravel</u>	<u>16</u>	<u>45</u>
<u>Gravel</u>	<u>45</u>	<u>63</u>
<u>(Shale)</u>	<u>63</u>	<u>132</u>
<u>Shale</u>	<u>132</u>	<u>157</u>
<u>Sand</u>	<u>157</u>	<u>200</u>

WELL PURPOSE: Home
 (home, irrigation, municipal, industrial)

- WELL COMPLETION DATA:
- (1) diameter (inches) 2"
 - (2) total depth (feet) 200 ft
 - (3) static water level (feet) 120 below above-top of ground.
 - (4) casing Plastic
 (material) (depth)
2" if telescope see back.
 (size)
 - (5) screen 10 ft 190 ft
 (length) (depth to top)
2" Plastic
 (size) (material)
 - (6) pump 1 1/2 8
 (HP) (yield gpm)
Elec
 (type power)
 - (7) electric log No
 (yes or no)
- (organization running log)
- (8) how well bottom plugged B.W. Valve


DRILLERS REMARKS:

RECEIVED
 OCT 25 1977

MISS. BD. OF WATER COMMISSIONERS

If well telescopes please sketch and show depths.

GROUND LEVEL

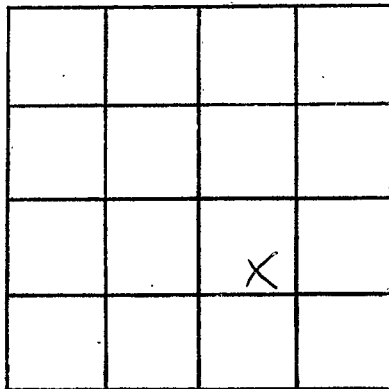

SECTION 23

Please indicate well location X.

ADDITIONAL INFORMATION

If more than one screen,
show locations of each on sketch.