

MARION
 N 2021
 5-23-77

MISSISSIPPI
 BOARD OF WATER COMMISSIONERS
 416 North State Street
 Jackson, Mississippi 39201

WATER WELL DRILLERS LOG

May 23 1977 date well completed
 Drinn Well Serv. Marion firm name
 Marion county well located

LANDOWNER:
 Mr. Garland Stephens
 Rt. 2 - Popworth, Miss.
 (mailing address)

description of formations encountered	from	to
Top Soil	0	1
Clay	1	38
Chalk	38	108
Shale	108	162
Chalk	162	202
Sand	202	245

WELL LOCATION:
 sec. 8 T 2 N R 13 E
 9 miles SW of Columbia
 (distance) (direction) (nearest town)

WELL PURPOSE: Home
 (home, irrigation, municipal, industrial)

- WELL COMPLETION DATA:
- (1) diameter (inches) 4"
 - (2) total depth (feet) 245
 - (3) static water level (feet) 90 below top of ground.
 - (4) casing Plastic, 225' (material) (depth)
 4" if telescope see back. (size)
 - (5) screen 20 ft, 225 ft (length) (depth to top)
 4" Plastic (size) (material)
 - (6) pump 3/4 HP 10 (HP) (yield gpm)
 Elec (type power)
 - (7) electric log no (yes or no)

(organization running log)


(8) how well bottom plugged
 B.W. Valve

DRILLERS REMARKS:

RECEIVED
 OCT 25 1977
 MISS. Bd. OF WATER COMMISSIONERS

If well telescopes please sketch and show depths.

GROUND LEVEL

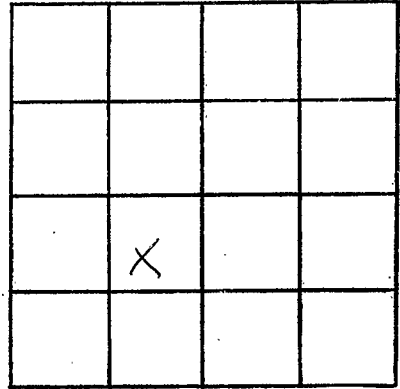

SECTION 8

Please indicate well location X.

ADDITIONAL INFORMATION

Lined area for additional information.

If more than one screen, show locations of each on sketch.