

MARION
N 2023
8-18-77

MISSISSIPPI
BOARD OF WATER COMMISSIONERS
416 North State Street
13V Jackson, Mississippi 39201

WATER WELL DRILLERS LOG

8/18 1977 Hollinger Well Marion
date well completed firm name county well located

LANDOWNER:	description of formations encountered	from	to
Pvt Bedwell Rt 3 Box 110 Foxworth, Miss. (mailing address)	CHALK, SAND SAND, GRAVEL	0	38 80

WELL LOCATION:
sec. 5 T. 2 N. R. 13 E
5 miles W of Chrean
(distance) (direction) (nearest town)

WELL PURPOSE: Home
(home, irrigation, municipal, industrial)

WELL COMPLETION DATA:

(1) diameter (inches) 2"

(2) total depth (feet) 80

(3) static water level (feet) 38 below above top of ground.

(4) casing PVC, 80, (material) (depth)
If telescope see back.
(size)

(5) screen 5, 75 (length) (depth to top)
2, PVC (size) (material)

(6) pump 1/2, 8 (HP) (yield gpm)
elect (type power)

(7) electric log (yes or no)
(organization running log)

(8) how well bottom plugged sand SHARK

DRILLERS REMARKS: good


RECEIVED

SEP 18 1977

MISS. BD. OF WATER COMMISSIONERS

If well telescopes please sketch and show depths.

GROUND LEVEL

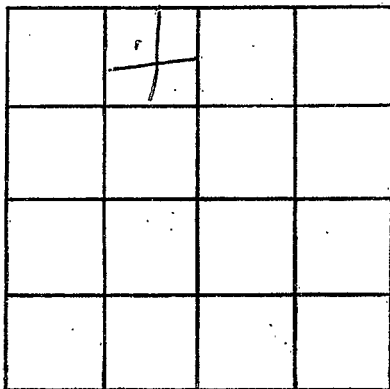

SECTION 5

Please indicate well location X.

ADDITIONAL INFORMATION

If more than one screen, show locations of each on sketch.