

MARION

N 2025

2-14-78

MISSISSIPPI BOARD OF WATER COMMISSIONERS 416 North State Street Jackson, Mississippi 39201

WATER WELL DRILLERS LOG

2/14 date well completed

1978 Hollingsworth Well Service firm name

Marion county well located

LANDOWNER: Herman Owens

RT1

Sandy Hook, MS. (mailing address)

WELL LOCATION:

sec. 14 T-2(N) R-13 E

7 miles S of Falmouth (distance) (direction) (nearest town)

WELL PURPOSE: Home (home, irrigation, municipal, industrial)

WELL COMPLETION DATA:


- (1) diameter (inches) 2"
(2) total depth (feet) 200
(3) static water level (feet) 140 below top of ground
(4) casing PVC 200 (material) (depth)
(5) screen 10 190 (length) (depth to top)
(6) pump 1 1/2 6 (HP) (yield gpm)
(7) electric log (type power) elect (yes or no)

(organization running log)

(8) how well bottom plugged sand SHARK

DRILLERS REMARKS: very good


Table with 3 columns: description of formations encountered, from, to. Contains handwritten entries: Sandy Chalk, Chalk, pea gravel with corresponding depth ranges.

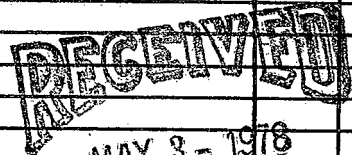

MISS. BD. OF WATER COMM

If well telescopes please  
sketch and show depths.

GROUND LEVEL

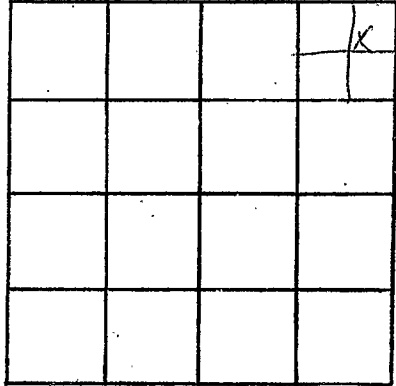

SECTION 14

Please indicate well location X.

ADDITIONAL INFORMATION

If more than one screen,  
show locations of each on sketch.