

MARION
N
3-1-78
2026
3-1

MISSISSIPPI
BOARD OF WATER COMMISSIONERS
416 North State Street
Jackson, Mississippi 39201

WATER WELL DRILLERS LOG

date well completed 19 78 Dr. B. W. Vaher Marion
well name Service county well located

LANDOWNER:
Mr. Leslie Pounds
Rt. 2 Fofworth, Miss
(mailing address)


description of fomations encountered	from	to
<u>Top Soil</u>	<u>0</u>	<u>1</u>
<u>Clay</u>	<u>1</u>	<u>25</u>
<u>Sand</u>	<u>25</u>	<u>55</u>

WELL LOCATION:
sec. 9 T. 20 N. R. 13 E
10 miles SW of Columbia
(distance) (direction) (nearest town)

WELL PURPOSE: Home
(home, irrigation, municipal, industrial)

- WELL COMPLETION DATA:
- (1) diameter (inches) 2"
 - (2) total depth (feet) 55 ft.
 - (3) static water level (feet) 15 ft. below top of ground.
 - (4) casing plastic 45 ft.
(material) (depth)
 - 2"
(size) if telescope see back.
 - (5) screen 10 ft. 45 ft.
(length) (depth to top)
 - 2" plastic
(size) (material)
 - (6) pump 1/2 HP Electric
(HP) (yield gpm) (type power)
 - (7) electric log no
(yes or no)
 - n/a
(organization running log)
 - (8) how well bottom plugged B. W. Vaher


DRILLERS REMARKS:

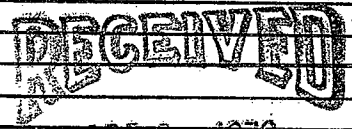

APR 27 1978

If well telescopes please sketch and show depths.

GROUND LEVEL

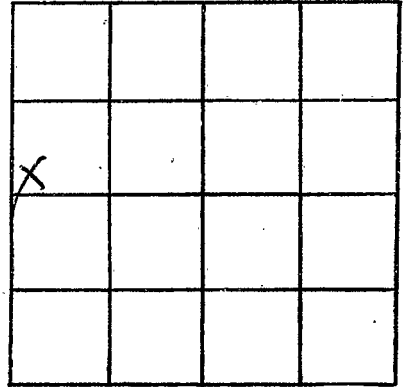

SECTION 9

Please indicate well location X.

ADDITIONAL INFORMATION

If more than one screen,
show locations of each on sketch.