

MARION
N
2027

MISSISSIPPI  
 BOARD OF WATER COMMISSIONERS  
 416 North State Street  
 Jackson, Mississippi 39201

WATER WELL DRILLERS LOG

TOM GRIFFITH

PLUMBING & WELL SERVICE, INC.

320 MAYSON AVE.

county well located

4-5-1978 date well completed

*Marion*

COLUMBIA, MISS 39425

LANDOWNER:	description of formations encountered	from	to
<i>Del Miller</i>	<i>Topsoil</i>	<i>0</i>	<i>2</i>
<i>Reeta &amp; Frederick</i>	<i>Gravel</i>	<i>2</i>	<i>52</i>
(mailing address)	<i>Sand</i>	<i>52</i>	<i>145</i>

WELL LOCATION:  
 sec *24 T 22 N* R *13 E*  
*2 S* W  
*2 1/2* miles *SW* of *Chesaw*  
 (distance) (direction) (nearest town)

WELL PURPOSE: *drill*  
 (home, irrigation, municipal, industrial)

- WELL COMPLETION DATA:
- (1) diameter (inches) 2"
  - (2) total depth (feet) 145
  - (3) static water level (feet) 25 below above top of ground.
  - (4) casing Plastic 135'  
 (material) (depth)
  - NA if telescope see back.  
 (size)
  - (5) screen 10' 135'  
 (length) (depth to top)
  - 2" Plastic  
 (size) (material)
  - (6) pump 1 4  
 (HP) (yield gpm)
  - elec  
 (type power)
  - (7) electric log NO  
 (yes or no)
  - NA  
 (organization running log)
  - (8) how well bottom plugged rock bottom


RECEIVED  
 MAY 24 1978

DRILLERS REMARKS:

MISS. BD. OF WATER COMMISSIONERS

If well telescopes please sketch and show depths.

GROUND LEVEL

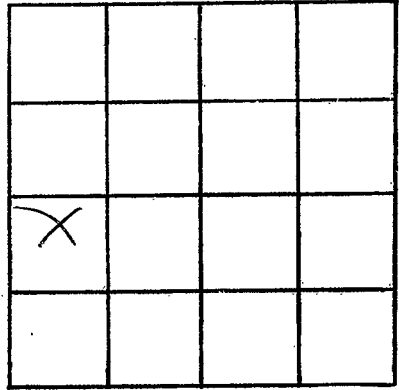

SECTION \_\_\_\_\_

Please indicate well location X.

ADDITIONAL INFORMATION

If more than one screen,  
show locations of each on sketch.