

MARION
N
208

MISSISSIPPI
BOARD OF WATER COMMISSIONERS
416 North State Street
Jackson, Mississippi 39201

WATER WELL DRILLERS LOG
TOM GRIFFITH
PLUMBING & WELL SERVICE, INC.

4-28-78
date well completed

320 MAYSON AVE.
COLUMBIA, MS 39429

Marion
county well located

LANDOWNER:

Mr. Jim Pandaridis
Rt. 2 Box 73 - Zephyrtown
(mailing address) Miss.

description of formations
encountered

	from	to
Top Soil	0	2
Clay	2	35
Sand	35	45
Chalk	45	120
Sand & gravel	120	147

WELL LOCATION:

sec. 3 T-2(N) R-12(E)
12 miles S-W of Columbia
(distance) (direction) (nearest town)

WELL PURPOSE: Home
(home, irrigation, municipal, industrial)

WELL COMPLETION DATA:

- diameter (inches) 4"
- total depth (feet) 147 ft
- static water level (feet) 160 ft below top of ground
- casing plastic 5/2" ft (material) (depth)
4" (size) If telescope see back.
- screen 2 ft, 127 ft (length) (depth to top)
4" (size) plastic (material)
- pump 3/4 H.P. (HP) (yield gpm)
Eled (type power)
- electric log No (yes or no)
N/A (organization running log)

(8) how well bottom plugged
B.W. Valve

DRILLERS REMARKS:


RECEIVED

MAY 24 1978

MISS. BD. OF WATER COMMISSIONERS

If well telescopes please sketch and show depths.

GROUND LEVEL

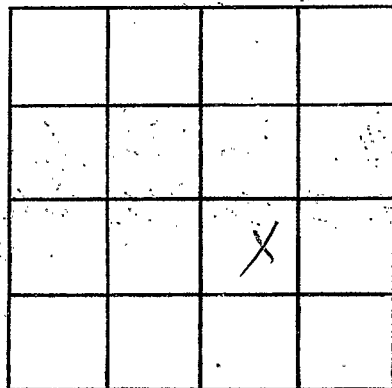

SECTION 3

Please indicate well location X.

ADDITIONAL INFORMATION

If more than one screen,
show locations of each on sketch.