

MARION

N 2029

6/12/78

MISSISSIPPI BOARD OF WATER COMMISSIONERS 416 North State Street Jackson, Mississippi 39201

WATER WELL DRILLERS LOG

6/12 date well completed

1978

Hollinger Well Service firm name

Marion county well located

LANDOWNER: Wilburn Shivers

RT2

description of formations encountered

from

to

Fotworth, Mo. (mailing address)

clay, gravel, chalk, sand, gravel

0 60, 60 70, 70 100, 100 140

WELL LOCATION:

sec. 2 T. 20N R. 20E

10 miles SW of Fotworth (distance) (direction) (nearest town)

WELL PURPOSE: Home (home, irrigation, municipal, industrial)


WELL COMPLETION DATA:

- (1) diameter (inches) 2"
(2) total depth (feet) 140
(3) static water level (feet) 70 below top of ground
(4) casing PVC, 135 (material) (depth)
(5) screen 5, 135 (length) (depth to top)
(6) pump 1, 8 (HP) (yield gpm)
(7) electric log (yes or no)

(organization running log)

(8) how well bottom plugged sand, SPARK

DRILLERS REMARKS: Very good

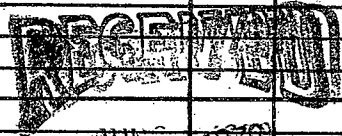


JUN 23 1978



If well telescopes please sketch and show depths.

GROUND LEVEL

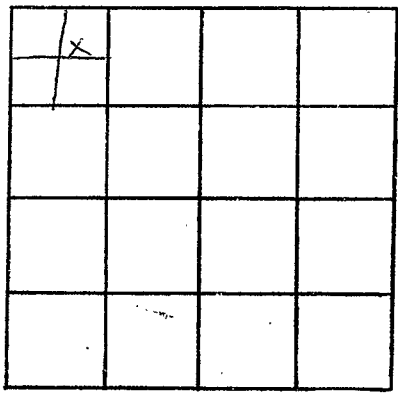

SECTION 2

Please indicate well location X.

ADDITIONAL INFORMATION

A series of horizontal lines for writing additional information.

If more than one screen, show locations of each on sketch.