

MARION
 N 2030
 01-19-79

MISSISSIPPI
 BOARD OF WATER COMMISSIONERS
 416 North State Street
 Jackson, Mississippi 39201

WATER WELL DRILLERS LOG

Jan 19 1979 TOM GRIFFITH
 date well completed PLUMBING & WELL SERVICE, INC. firm name Marion county well located

LANDOWNER:	description of formations encountered	from	to
Mrs. Johanna Evans Rt. 3 - Box 187 - Jothwart (mailing address) Miss	Top soil clay sand gravel chert sand	0 4 6 19 40	1 6 19 40
WELL LOCATION: sec. 3 T 2 N R 12 E S W 2 miles SE of Hobbs (distance) (direction) (nearest town)			
WELL PURPOSE: Home (home, irrigation, municipal, industrial)			
WELL COMPLETION DATA: (1) diameter (inches) 2" (2) total depth (feet) 155 ft. (3) static water level (feet) 100 ft below top of ground. (4) casing plastic, 90 ft (material) (depth) 2" (size) if telescope see back. (5) screen 10 ft, 90 ft (length) (depth to top) 2" plastic (size) (material) (6) pump 1 1/2 HP, 10 (yield gpm) Electric (type power) (7) electric log yes (yes or no) (organization running log) (8) how well bottom plugged B. Wash Valve			

DRILLERS REMARKS:


Miss. Board of Water Comm.

MAY - 4 1979

RECEIVED

If well telescopes please sketch and show depths.

GROUND LEVEL

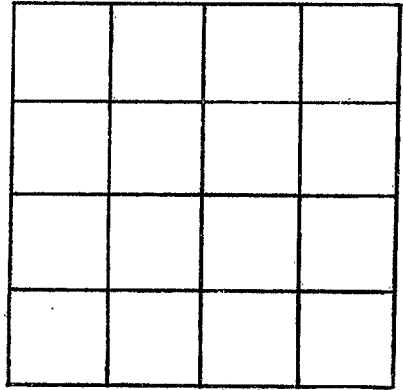

SECTION _____

Please indicate well location X.

ADDITIONAL INFORMATION

If more than one screen,
show locations of each on sketch.