

MARION
 N 2031
 3-12-79

MISSISSIPPI
 BOARD OF WATER COMMISSIONERS
 416 North State Street
 Jackson, Mississippi 39201

WATER WELL DRILLERS LOG

March 12 1979 Stuffed Well Co. Marion Co.
 date well completed firm name county well located

LANDOWNER:
 Shelton Carr
 (mailing address)

WELL LOCATION:
 sec. 4 T. 2 N. R. 12 E.
 6 miles west of Lumberton
 (distance) (direction) (nearest town)

WELL PURPOSE:
 (home, irrigation, municipal, industrial)

WELL COMPLETION DATA:

(1) diameter (inches) 2"
 (2) total depth (feet) 170
 (3) static water level (feet) 70 below top of ground
 (4) casing (material) plastic (depth) 160
 (size) 2" If telescope see back.
 (5) screen (length) 10 ft (depth to top) 160
 (size) 2" (material) plastic
 (6) pump (HP) 1/2 (yield gpm) 12
 (type power) Elect
 (7) electric log (yes or no)
 (organization running log)
 (8) how well bottom plugged BWD

description of formations encountered	from	to
Top soil	0	21
sandy clay	1	60
chalk	60	90
fine sand	90	150
coarse sand	150	170


DRILLERS REMARKS:
 [Signature]

DEPT. OF NATURAL RESOURCES
 BUREAU OF LAND & WATER RESOURCES

MAY 27 1980
 RECEIVED

If well telescopes please sketch and show depths.

GROUND LEVEL

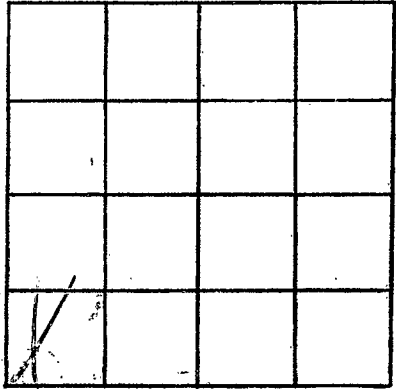

SECTION _____

Please indicate well location X.

ADDITIONAL INFORMATION

If more than one screen, show locations of each on sketch.