

Marion  
N 2032  
12-3-79

MISSISSIPPI  
 BOARD OF WATER COMMISSIONERS  
 416 North State Street  
 Jackson, Mississippi 39201

WATER WELL DRILLERS LOG

12/3 1979 TOM Giffith Marion  
 date well completed firm name county well located

LANDOWNER:  
Joe Miller  
Rt. 2, Box 154-A, Foxworth, Ms.  
 (mailing address)

description of formations encountered	from	to
<u>top soil</u>	<u>0</u>	<u>3</u>
<u>sand</u>	<u>3</u>	<u>30</u>
<u>chalk</u>	<u>30</u>	<u>50</u>
<u>sand</u>	<u>50</u>	<u>130</u>

WELL LOCATION:  
 sec. 24 T. 20 N. R. 14 E  
6 miles South of Columbia  
 (distance) (direction) (nearest town)

WELL PURPOSE:  
 (home, irrigation, municipal, industrial)

- WELL COMPLETION DATA:
- (1) diameter (inches) 2"
  - (2) total depth (feet) 130'
  - (3) static water level (feet) 80' below above top of ground.
  - (4) casing Plastic, 20'  
 (material) (depth)  
2" If telescope see back.  
 (size)
  - (5) screen 20', 110'  
 (length) (depth to top)  
2", plastic  
 (size) (material)
  - (6) pump 1 (HP) (yield gpm)  
Elect  
 (type power)
  - (7) electric log No  
 (yes or no)  
None  
 (organization running log)
  - (8) how well bottom plugged B.W.V.

DRILLERS REMARKS:


DEPT. OF NATURAL RESOURCES  
 BUREAU OF LAND & WATER RESOURCES

JAN 7 1980

RECEIVED

If well telescopes please sketch and show depths.

GROUND LEVEL

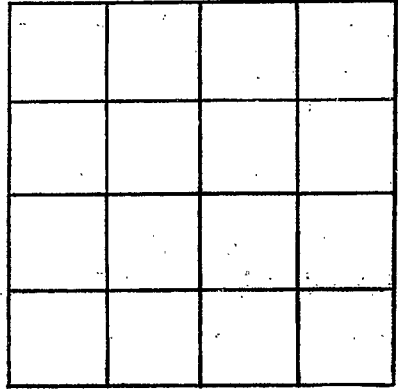

SECTION \_\_\_\_\_

Please indicate well location X.

ADDITIONAL INFORMATION

If more than one screen, show locations of each on sketch.