

MARION
 N 234
 May 10, 1979

MISSISSIPPI
 BOARD OF WATER COMMISSIONERS
 416 North State Street
 Jackson, Mississippi 39201

WATER WELL DRILLERS LOG

May 10 1979 TOM GRIFFITH
 date well completed PLUMBING & WELL SERVICE, INC. county well located
 320 MAYSON AVE. *Miss.*
 COLUMBIA, MS. 39229

LANDOWNER:

Mr. Willie Armstrong
 Kokomo, Miss.
 (mailing address)

WELL LOCATION:

sec. 25 T 2 N R 13 E
 10 miles E of Columbus
 (distance) (direction) (nearest town)

WELL PURPOSE:

WATER
 (home, irrigation, municipal, industrial)

WELL COMPLETION DATA:

- (1) diameter (inches) 2"
- (2) total depth (feet) 230 ft
- (3) static water level (feet) 160 ft below top of ground.
- (4) casing plastic, 210 ft
 (material) (depth)
2" if telescope see back.
 (size)
- (5) screen 20 ft, 210 ft.
 (length); (depth to top)
2" plastic
 (size) (material)
- (6) pump 1 HP 10 gpm
 (HP) (yield gpm)
Electric
 (type power)
- (7) electric log No
 (yes or no)

(organization running log)

- (8) how well bottom plugged

DRILLERS REMARKS:

B.W. Valve

description of formations encountered

description of formations encountered	from	to
Top Soil	0	1
Clay	1	26
Sand	26	49
Clay	49	57
Gravel	57	144
Large Gravel	144	152
Sand	152	230


Miss. Board of Water Comm.

JUL 9 1979

RECEIVED

If well telescopes please sketch and show depths.

GROUND LEVEL

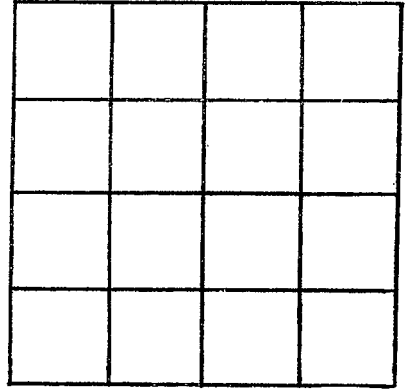

SECTION _____

Please indicate well location X.

ADDITIONAL INFORMATION

If more than one screen, show locations of each on sketch.