

MARION  
 N 2036  
 3-5-80

MISSISSIPPI  
 BOARD OF WATER COMMISSIONERS  
 416 North State Street  
 Jackson, Mississippi 39201

WATER WELL DRILLERS LOG

3-5 1980 No. 1000 Well No. Marion  
 date well completed fish name county well located

LANDOWNER: Wendall  
 Rt. 2 Breakfield  
 Joxworth Ms.  
 (mailing address)

description of formations encountered	from	to
Sand, CHALK	0	100
GRAVEL	100	150
SAND, GRAVEL	150	175

WELL LOCATION:  
 sec. 11 T. 2 N. R. 13 E  
 8 miles SW of Foxworth  
 (distance) (direction) (nearest town)

WELL PURPOSE:  
 (home, irrigation, municipal, industrial)

- WELL COMPLETION DATA:
- (1) diameter (inches) 4
  - (2) total depth (feet) 175
  - (3) static water level (feet) 100 below above top of ground.
  - (4) casing PVC 165 (material) (depth)
  - (size) If telescope see back.
  - (5) screen 10 165 (length) (depth to top)
  - 4 PVC (size) (material)
  - (6) pump 1 18 (HP) (yield gpm)
  - elect (type power)
  - (7) electric log (yes or no)
  - (organization running log)

(8) how well bottom plugged sand SPARK


DRILLERS REMARKS: good well

DEPT. OF NATURAL RESOURCES  
 BUREAU OF LAND & WATER RESOURCES

APR 14 1980  
 RECEIVED

If well telescopes please sketch and show depths.

GROUND LEVEL

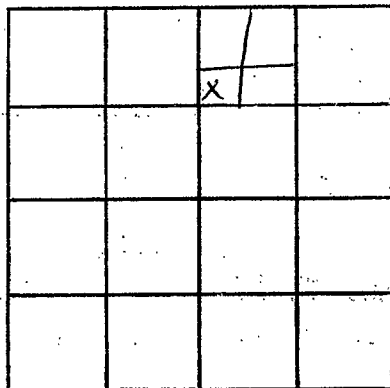

SECTION 11

Please indicate well location X.

ADDITIONAL INFORMATION

If more than one screen, show locations of each on sketch.