

MARION
 N 2037
 4-3-80

MISSISSIPPI
 BOARD OF WATER COMMISSIONERS
 416 North State Street
 Jackson, Mississippi 39201

WATER WELL DRILLERS LOG

4-3-80 1980 Hollingsworth Marion
 date well completed firm name county well located

LANDOWNER: Mike Stovall
 Rt 1
 Foxworth, MS
 (mailing address)

description of formations encountered	from	to
SAND, CHALK	0	60
pea gravel	60	95

WELL LOCATION:
 sec. 3 T 20 N R 12 E
 S W
 7 miles E of Kokomo
 (distance) (direction) (nearest town)

WELL PURPOSE:
 (home, irrigation, municipal, industrial)

- WELL COMPLETION DATA:
- (1) diameter (inches) 2
 - (2) total depth (feet) 95
 - (3) static water level (feet) 50 ^{below} _{above} top of ground.
 - (4) casing pvc, 90,
 (material) (depth)
 (size) If telescope see back.
 - (5) screen 5, 90
 (length) (depth to top)
2, pvc
 (size) (material)
 - (6) pump 1, 8
 (HP) (yield gpm)
elect
 (type power)
 - (7) electric log
 (yes or no)


(organization running log)
 (8) how well bottom plugged sand
SHARK

DRILLERS REMARKS: good

DEPT. OF NATURAL RESOURCES
 BUREAU OF LAND & WATER DIVISION
 APR 14 1980
 RECEIVED

If well telescopes please sketch and show depths.

GROUND LEVEL

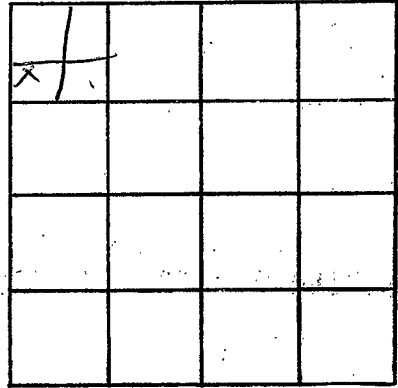

SECTION 3

Please indicate well location X.

ADDITIONAL INFORMATION

If more than one screen, show locations of each on sketch.