

MARION
N 2038
5/1/80

MISSISSIPPI
BOARD OF WATER COMMISSIONERS
416 North State Street
Jackson, Mississippi 39201

WATER WELL DRILLERS LOG

19 TOM GRIFFITH firm name main county well located

LANDOWNER: Michiel Patrice
Rt 2 Foxworth
(mailing address)

description of formations encountered	from	to
<u>TOP SOIL</u>	<u>0</u>	<u>5</u>
<u>SAND GRVAL</u>	<u>5</u>	<u>130</u>

WELL LOCATION:
sec. 12 T. 2N R. 12E
S S W
5 miles SOUTH of FOXWORTH
(distance) (direction) (nearest town)

WELL PURPOSE: Home
(home, irrigation, municipal, industrial)

- WELL COMPLETION DATA:
- (1) diameter (inches) 2"
 - (2) total depth (feet) 130
 - (3) static water level (feet) 45 below top of ground
 - (4) casing 2" (material) 130 (depth)
2" If telescope see back. (size)
 - (5) screen 20 (length) 10 (depth to top)
2" (size) Plastic (material)
 - (6) pump 1 (HP) 10 (yield gpm)
Electric (type power)
 - (7) electric log no (yes or no)

(organization running log)
(8) how well bottom plugged Back
WASH (M)

DRILLERS REMARKS:


DEPT. OF NATURAL RESOURCES
BUREAU OF LAND & WATER RESOURCES

MAY 8 - 1980

RECEIVED

If well telescopes please sketch and show depths.

GROUND LEVEL

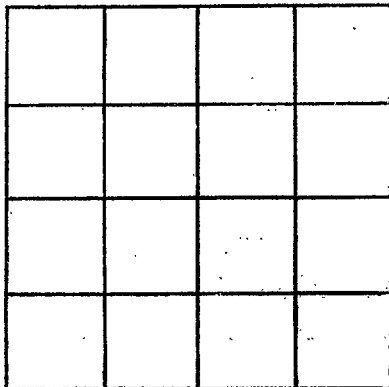

SECTION _____

Please indicate well location X.

ADDITIONAL INFORMATION

If more than one screen, show locations of each on sketch.

*South Bay
Water*