

MARION
 N 2040
 10-4-80

MISSISSIPPI
 BOARD OF WATER COMMISSIONERS
 416 North State Street
 Jackson, Mississippi 39201
 WATER WELL DRILLERS LOG

10-4 1980 Hollinger MARION
 date well completed firm name county well located

LANDOWNER: Bob Pittman
 Rt 2
 Foxworth, MS
 (mailing address)

description of formations encountered	from	to
	clay gravel, sand	0 20

WELL LOCATION:
 sec. 4 T 21N R 130E
 S W
 2 miles W of Chrewe
 (distance) (direction) (nearest town)

WELL PURPOSE:
 (home, irrigation, municipal, industrial)


- WELL COMPLETION DATA:
- (1) diameter (inches) 2
 - (2) total depth (feet) 60
 - (3) static water level (feet) 30 below top of ground.
 - (4) casing PVC, 55 (material) (depth)
 (size) if telescope see back.
 - (5) screen 5, 55 (length) (depth to top)
 2, PVC (size) (material)
 - (6) pump 1, 8 (HP) (yield gpm)
 elect (type power)
 - (7) electric log (yes or no)

(8) how well bottom plugged sand
 shark
 DRILLERS REMARKS: Good well

DEPT. OF NATURAL RESOURCES
 BUREAU OF LAND & WATER RESOURCES
 OCT 20 1980
 RECEIVED

If well telescopes please sketch and show depths.

GROUND LEVEL

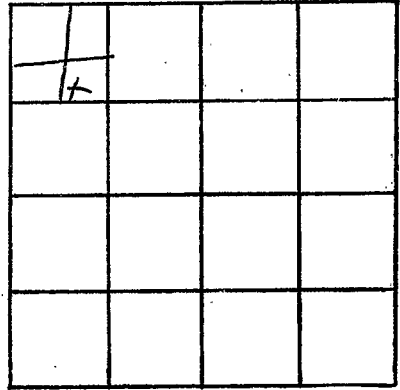

SECTION 4

Please indicate well location X.

ADDITIONAL INFORMATION

A series of horizontal lines for recording additional information.

If more than one screen, show locations of each on sketch.