

Marion
 N 2041
 9-3-80

MISSISSIPPI
 BOARD OF WATER COMMISSIONERS
 416 North State Street
 Jackson, Mississippi 39201

WATER WELL DRILLERS LOG

9-3
 date well completed

1980 Fidelity Well Sew
 firm name

Marion
 county well located

LANDOWNER:	description of formations encountered	from	to
Steve Rowell R.P. Foxworth (mailing address)	Red Soil white soil Coarse sand & gravel	2 10 50	10 50 61
WELL LOCATION: sec. 12 T. 2 N. S. R. 13 E. W. 1 1/2 miles of Chermaw (distance) (direction) (nearest town)			
WELL PURPOSE: Home (home, irrigation, municipal, industrial)			
WELL COMPLETION DATA: (1) diameter (inches) 4 (2) total depth (feet) 61 (3) static water level (feet) 12 below top of ground. (4) casing PVC, 53 (material), (depth) 4 (size) if telescope see back. (5) screen 8, 53 (length), (depth to top) 4, PVC (size), (material) (6) pump 1/2, 10 (HP), (yield gpm) EL (type power) (7) electric log no (yes or no) (organization running log) (8) how well bottom plugged Seal block			


DRILLERS REMARKS:

DEPT. OF NATURAL RESOURCES
 BUREAU OF LAND & WATER RESOURCES

SEP 8 - 1980
 RECEIVED

If well telescopes please sketch and show depths.

GROUND LEVEL

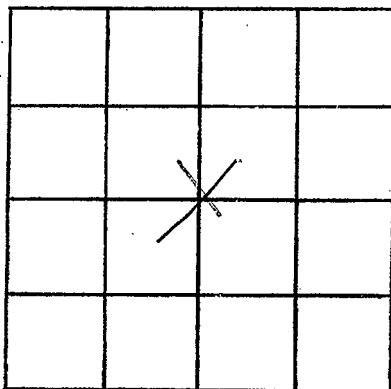

SECTION 12

Please indicate well location X.

ADDITIONAL INFORMATION

If more than one screen,
show locations of each on sketch.