

Marion  
 PN 2042  
 9-8-81

MISSISSIPPI  
 BOARD OF WATER COMMISSIONERS  
 416 North State Street  
 Jackson, Mississippi 39201

WATER WELL DRILLERS LOG


9-8 1981 F. J. ... Marion  
 date well completed firm name county well located

LANDOWNER:	description of formations encountered	from	to
CAT HOILK			
R.R. Sandy Hook - (mailing address)	Red clay Red Sand Coarse sand & gravel	0 20 40	10 40 54
WELL LOCATION: sec. 24 T. 2 N R. 13 E S W			
8 miles S of Foxworth (distance) (direction) (nearest town)			
WELL PURPOSE: Home (home, irrigation, municipal, industrial)			
WELL COMPLETION DATA:			
(1) diameter (inches) 4			
(2) total depth (feet) 54			
(3) static water level (feet) 6 below top of ground. above			
(4) casing PVC, 46 (material) (depth)			
4 (size) if telescope see back.			
(5) screen 8, 46 (length) (depth to top)			
4, PVC (size) (material)			
(6) pump 1/2, 1 (HP) (yield gpm)			
Electric (type power)			
(7) electric log yes (yes or no)			
(organization running log)			
(8) how well bottom plugged <u>Sand</u>			
DRILLERS REMARKS:			

DEPT. OF NATURAL RESOURCES  
 BUREAU OF LAND & WATER RESOURCES  
 SEP 30 1981  
 RECEIVED

If well telescopes please sketch and show depths.

GROUND LEVEL

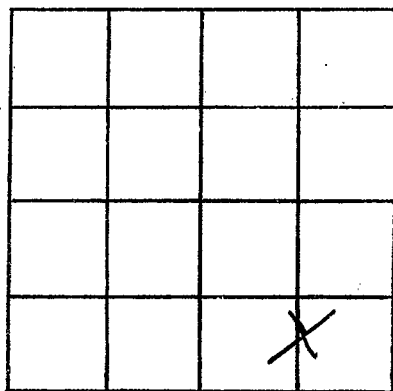

SECTION 24

Please indicate well location X.

ADDITIONAL INFORMATION

If more than one screen, show locations of each on sketch.