

MARION
N 2043
4-26-81

MISSISSIPPI
BOARD OF WATER COMMISSIONERS
416 North State Street
Jackson, Mississippi 39201

WATER WELL DRILLERS LOG

4-26 1981 Hallinger MARION
date well completed firm name county well located

LANDOWNER: Miles Jones RT 3	description of formations encountered	from	to
Foxworth, Ms. (mailing address)	sand, gravel chert coarse sand, gravel	0 160 215	160 215 245
<p>WELL LOCATION:</p> <p>sec. 5 T. 20 N. R. 19 E. 13 7 miles SW of Foxworth (distance) (direction) (nearest town)</p>			
<p>WELL PURPOSE: Home (home, irrigation, municipal, industrial)</p>			
<p>WELL COMPLETION DATA:</p>			
<p>(1) diameter (inches) 2"</p>			
<p>(2) total depth (feet) 245</p>			
<p>(3) static water level (feet) 150 below above top of ground.</p>			
<p>(4) casing PVC 245 (material) (depth)</p>			
<p>if telescope see back. (size)</p>			
<p>(5) screen 10 245 (length) (depth to top)</p>			
<p>2 PVC (size) (material)</p>			
<p>(6) pump 2 5 (HP) (yield gpm)</p>			
<p>elect (type power)</p>			
<p>(7) electric log (yes or no)</p>			
<p>(organization running log)</p>			
<p>(8) how well bottom plugged sand shale</p>			
<p>DRILLERS REMARKS: good well</p>			


DEPT. OF NATURAL RESOURCES
BUREAU OF LAND & WATER RESOURCES

MAY 13 1981

RECEIVED

If well telescopes please sketch and show depths.

GROUND LEVEL

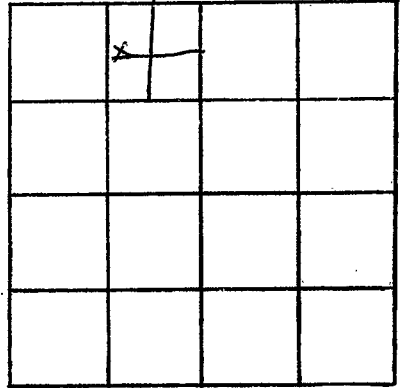

SECTION 5

Please indicate well location X.

ADDITIONAL INFORMATION

If more than one screen, show locations of each on sketch.