

Marion
 N 2044
 2-25-81

MISSISSIPPI
 BOARD OF WATER COMMISSIONERS
 416 North State Street
 Jackson, Mississippi 39201

WATER WELL DRILLERS LOG

2-25 1981 date well completed
 Fitzgull well firm name
 Marion county well located

LANDOWNER:	description of formations encountered	from	to
Reelro Waldley			
R.R. Kokomo (mailing address)	Red clay	0	20
	Red sand	20	90
	Coarse sand	90	139

WELL LOCATION:
 sec. 4 T. 20N S. R. 12E W.
 2 miles S of Kokomo
 (distance) (direction) (nearest town)

WELL PURPOSE:
 (home, irrigation, municipal, industrial)

- WELL COMPLETION DATA:
- (1) diameter (inches) 4
 - (2) total depth (feet) 139
 - (3) static water level (feet) 95 below top of ground.
 - (4) casing PVC 131 (material) (depth)
 4 (size) if telescope see back.
 - (5) screen 8 131 (length) (depth to top)
 4 PVC (size) (material)
 - (6) pump 1/2 10 (HP) (yield gpm)
 elec (type power)
 - (7) electric log ne (yes or no)
 (organization running log)
 - (8) how well bottom plugged Seal Plug


DRILLERS REMARKS:

DEPT. OF NATURAL RESOURCES
 BUREAU OF LAND & WATER RESOURCES

APR 29 1981
 RECEIVED

If well telescopes please sketch and show depths.

GROUND LEVEL

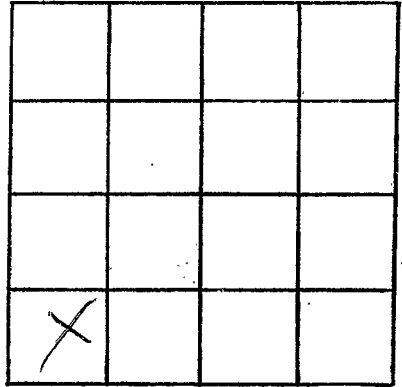

SECTION 4

Please indicate well location X.

ADDITIONAL INFORMATION

If more than one screen, show locations of each on sketch.