

MISSISSIPPI DEPARTMENT OF NATURAL RESOURCES

Bureau of Land and Water Resources

Southport Mall

P.O. Box 10631

Jackson, Mississippi 39209

WATER WELL DRILLERS LOG

Monroe
N
2047

12-5 19 83 Hollinger Monroe
 date well completed firm name county well located

LANDOWNER: Bob Stevenson description of formations encountered from to
Rt 2
Foxworth MS (mailing address) Red clay 0 20
gravel, sand 20 60

WELL LOCATION:
 sec. 11 T 2 N S R 13 E W
6 miles S of Foxworth
 (distance) (direction) (nearest town)

WELL PURPOSE:
 (home, irrigation, municipal, industrial)

WELL COMPLETION DATA:
 (1) diameter (inches) 4 1/2"
 (2) total depth (feet) 60
 (3) static water level (feet) 30 below above top of ground.
 (4) casing pvc (material), (depth) _____ If telescope see back. (size)
 (5) screen 10 50 (length), (depth to top)
4 (size), pvc (material)
 (6) pump 1/2 (HP) 12 (yield gpm)
elect (type power)
 (7) electric log (yes or no) _____
 (organization running log) _____

(8) how well bottom plugged sand
shank

DRILLERS REMARKS: Good well


DEPT. OF NATURAL RESOURCES
 BUREAU OF LAND & WATER RESOURCES

DEC - 9 1983

RECEIVED

If well telescopes please sketch and show depths.

GROUND LEVEL

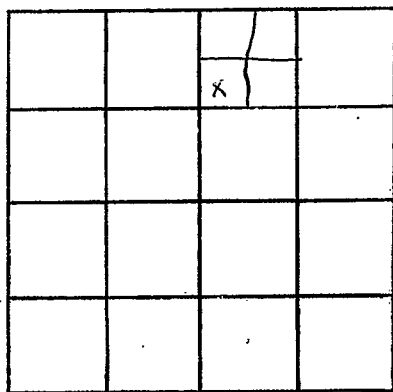

SECTION 11

Please indicate well location X.

ADDITIONAL INFORMATION

If more than one screen, show locations of each on sketch.