

MISSISSIPPI DEPARTMENT OF NATURAL RESOURCES

Bureau of Land and Water Resources

Southport Mall

P.O. Box 10631

Jackson, Mississippi 39209

WATER WELL DRILLERS LOG

MARION
N 2049

4-23 1984 *Hollings* *Marion*
date well completed firm name county well located

LANDOWNER: <i>Delma Batwell</i>	description of formations encountered	from	to
<i>Rt 2</i>	<i>Chalk</i>	<i>0</i>	<i>30</i>
<i>Forworth Ms</i> (mailing address)	<i>sand, gravel</i>	<i>30</i>	<i>55</i>
	<i>plastic gravel, sand</i>	<i>55</i>	<i>100</i>
<p>WELL LOCATION: sec. <i>21</i> T. <i>20</i> N. R. <i>13</i> E <i>7</i> miles <i>NW</i> of <i>Forworth</i> (distance) (direction) (nearest town)</p>			
<p>WELL PURPOSE: (home, irrigation, municipal, industrial)</p>			
<p>WELL COMPLETION DATA:</p>			
<p>(1) diameter (inches) <i>2"</i></p>			
<p>(2) total depth (feet) <i>100</i></p>			
<p>(3) static water level (feet) <i>30</i> below top of ground.</p>			
<p>(4) casing <i>pvc</i> (material), (depth), (size) if telescope see back.</p>			
<p>(5) screen <i>10</i> (length), <i>70</i> (depth to top), (size), (material)</p>			
<p>(6) pump <i>1</i> (HP), <i>10</i> (yield gpm), (type power) <i>elect</i></p>			
<p>(7) electric log (yes or no) (organization running log)</p>			
<p>(8) how well bottom plugged <i>SAND SHANK</i></p>			
<p>DRILLERS REMARKS: <i>good well</i></p>			


DEPT. OF NATURAL RESOURCES
BUREAU OF LAND & WATER RESOURCES

JUL 31 1984

RECEIVED

If well telescopes please sketch and show depths.

GROUND LEVEL

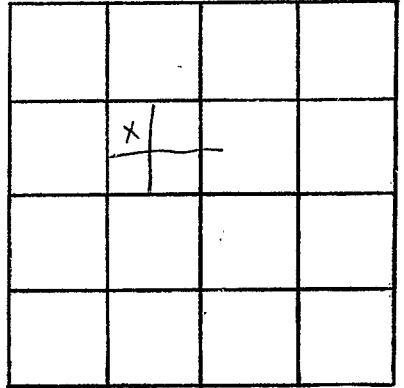

SECTION 21

Please indicate well location X.

ADDITIONAL INFORMATION

If more than one screen,
show locations of each on sketch.