

MISSISSIPPI DEPARTMENT OF NATURAL RESOURCES

Bureau of Land and Water Resources

Southport Mall

P.O. Box 10631

Jackson, Mississippi 39209

WATER WELL DRILLERS LOG

MARION
N 2050

May 9 1984 By Rivers Well Service Marion
date well completed firm name county well located

LANDOWNER:
Charles Lee
Rt Foyworth
(mailing address)

description of formations encountered	from	to
<u>clay</u>	<u>0</u>	<u>14</u>
<u>sand & gravel</u>	<u>14</u>	<u>36</u>
<u>clay & sand</u>	<u>36</u>	<u>52</u>
<u>fine sand</u>	<u>52</u>	<u>70</u>
<u>coarse sand</u>	<u>70</u>	<u>82</u>

WELL LOCATION:
sec. 19 T. 12 N. R. 13 E
9 miles SE of Foyworth
(distance) (direction) (nearest town)

WELL PURPOSE: house
(home, irrigation, municipal, industrial)

WELL COMPLETION DATA:

(1) diameter (inches) 4"

(2) total depth (feet) 82

(3) static water level (feet) 18 below top of ground.

(4) casing plastic (material) bottom (depth)

(size) if telescope see back.

(5) screen 6' (length) 76' (depth to top)

(size) (material) 4" plastic

(6) pump 1/2 hp (HP) 10 (yield gpm)

(type power) electric

(7) electric log no (yes or no)

(organization running log)

(8) how well bottom plugged good well

DRILLERS REMARKS:


MISSISSIPPI DEPARTMENT OF NATURAL RESOURCES
BUREAU OF LAND & WATER RESOURCES

JUL 10 1984

RECEIVED

If well telescopes please sketch and show depths.

GROUND LEVEL

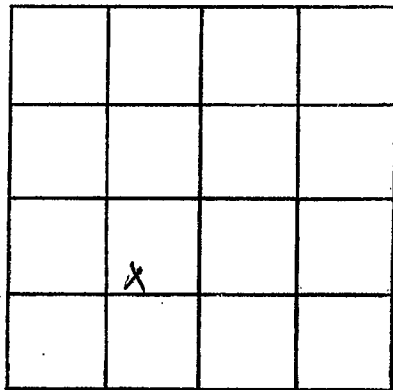

SECTION 19

Please indicate well location X.

ADDITIONAL INFORMATION

If more than one screen, show locations of each on sketch.