

MISSISSIPPI DEPARTMENT OF NATURAL RESOURCES

Bureau of Land and Water Resources

Southport Mall

P.O. Box 10631

Jackson, Mississippi 39209

WATER WELL DRILLERS LOG

N 2052
MARION
8-7-85

8-7 1985 Fitzgerald Well Serv Marion
 date well completed firm name county well located

LANDOWNER:	description of formations encountered	from	to
<u>Joe Ray</u> <u>P.O. Foxworth, Ms.</u> (mailing address)			
	<u>Red silt</u>	<u>20</u>	<u>180</u>
	<u>Coarse sand & gravel</u>	<u>180</u>	<u>195</u>

WELL LOCATION:
 sec. 7 T 2 N R 13 E
 S W
4 miles SE of Kokomo
 (distance) (direction) (nearest town)

WELL PURPOSE: Home
 (home, irrigation, municipal, industrial)

- WELL COMPLETION DATA:
- (1) diameter (inches) 4
 - (2) total depth (feet) 195
 - (3) static water level (feet) 125 below above top of ground.
 - (4) casing PVC, 185,
 (material) (depth)
4 if telescope see back.
 (size)
 - (5) screen 10, 185
 (length) (depth to top)
4, PVC
 (size) (material)
 - (6) pump 3/4, 15
 (HP) (yield gpm)
elec
 (type power)
 - (7) electric log no
 (yes or no)
 (organization running log)
 - (8) how well bottom plugged Sand Seal


DRILLERS REMARKS:

RECEIVED
 SEP 13 1985

Department of Natural Resources
 Bureau of Land & Water Resources

If well telescopes please sketch and show depths.

GROUND LEVEL

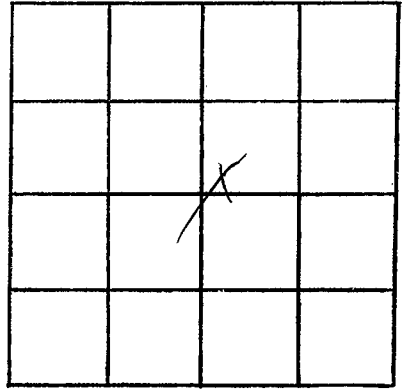

SECTION 2

Please indicate well location X.

ADDITIONAL INFORMATION

If more than one screen,
show locations of each on sketch.