

MISSISSIPPI DEPARTMENT OF NATURAL RESOURCES

Bureau of Land and Water Resources

Southport Mall

P.O. Box 10631

Jackson, Mississippi 39209

WATER WELL DRILLERS LOG

MARION
N 2053

5-1
date well completed

19 86

F. Lowell well Ser
firm name

Marion
county well located

LANDOWNER:

J. D. Leverage

R.R. Foxworth, Mrs.
(mailing address)

description of formations encountered

from

to

Red clay

0 20

Red sand

20 130

Coarse sand & gravel

130 146

WELL LOCATION:

sec. 18 T 2 N R 13 E
S W

4 miles NE of Dexter
(distance) (direction) (nearest town)


WELL PURPOSE:

Home
(home, irrigation, municipal, industrial)

WELL COMPLETION DATA:

- (1) diameter (inches) 4
- (2) total depth (feet) 146
- (3) static water level (feet) 85 below above top of ground.
- (4) casing PVC, 136
(material) (depth)
4 (size) if telescope see back.
- (5) screen 10, 136
(length) (depth to top)
4 (size) PVC (material)
- (6) pump 1/2, 10
(HP) (yield gpm)
Elec (type power)
- (7) electric log No
(yes or no)
(organization running log)
- (8) how well bottom plugged Sand Plug


DRILLERS REMARKS:

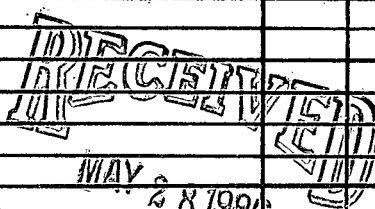

Department of Natural Resources
Bureau of Land & Water Resources

If well telescopes please sketch and show depths.

GROUND LEVEL

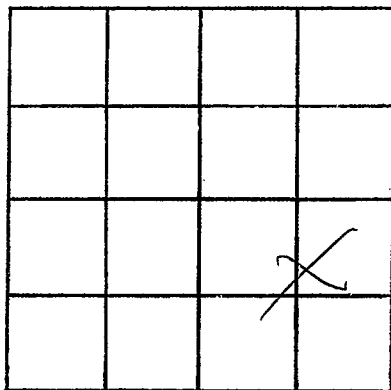

SECTION 18

Please indicate well location X.

ADDITIONAL INFORMATION

If more than one screen,
show locations of each on sketch.