

MISSISSIPPI DEPARTMENT OF NATURAL RESOURCES

Bureau of Land and Water Resources

Southport Mall

P.O. Box 10631

Jackson, Mississippi 39209

WATER WELL DRILLERS LOG

Marion  
N 2054




11/11/86 Tom Griffith Well Ser. Marion  
date well completed firm name county well located

LANDOWNER: <u>George Ervin</u> <u>178-1</u>	description of formations encountered	from	to
<u>Columbia, Ms.</u> (mailing address)	<u>Clay</u> <u>Sand</u>	<u>0</u>	<u>40</u> <u>40</u> <u>100</u>
WELL LOCATION: sec. <u>13 T 20 N</u> R. <u>13 E</u> <u>8</u> miles <u>S</u> of <u>Columbia</u> (distance) (direction) (nearest town)			
WELL PURPOSE: <u>Home</u> (home, irrigation, municipal, industrial)			
WELL COMPLETION DATA:			
(1) diameter (inches) <u>2 in.</u>			
(2) total depth (feet) <u>100</u>			
(3) static water level (feet) <u>20</u> <u>below</u> above top of ground.			
(4) casing <u>PVC</u> , <u>40</u> , (material) (depth) <u>2"</u> (size) if telescope see back.			
(5) screen <u>60</u> <u>40</u> (length) (depth to top) <u>2"</u> <u>PVC</u> (size) (material)			
(6) pump <u>1</u> <u></u> (HP) (yield gpm) <u>Jet</u> (type power)			
(7) electric log <u>No</u> (yes or no) <u>NA</u> (organization running log)			
(8) how well bottom plugged <u>BWW</u>			
DRILLERS REMARKS:			

If well telescopes please sketch and show depths.

GROUND LEVEL

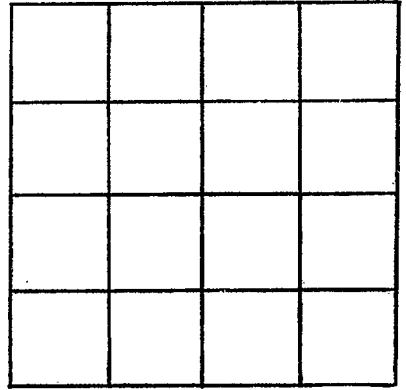

SECTION \_\_\_\_\_

Please indicate well location X.

ADDITIONAL INFORMATION

RECEIVED

SEP 28 1987

Dept. of Natural Resources  
Bureau of Land & Water Resources

If more than one screen,  
show locations of each on sketch.