

MISSISSIPPI DEPARTMENT OF NATURAL RESOURCES

Bureau of Land and Water Resources

Southport Mall

P.O. Box 10631

Jackson, Mississippi 39209

WATER WELL DRILLERS LOG

MAURON  
M 2002  
2055

12-1-81  
date well completed

Hollinger Well  
firm name

MAURON  
county well located

LANDOWNER: DR Robert Cook

RTA

Foxworth, MS  
(mailing address)

description of formations encountered

from

to

chalk	0	20
sand, gravel	20	85

WELL LOCATION:

sec. 17 T. 20 N. R. 13 E  
10 miles S of Foxworth  
(distance) (direction) (nearest town)

WELL PURPOSE:

(home, irrigation, municipal, industrial)

WELL COMPLETION DATA:

- (1) diameter (inches) 4"
- (2) total depth (feet) 85
- (3) static water level (feet) 15 (below/above top of ground)
- (4) casing PVC (material), (depth)

(size) if telescope see back.

- (5) screen 10 (length), 75 (depth to top)
- (size) 4, (material) PVC

- (6) pump 1/2 (HP), 10 (yield gpm)


elect  
(type power)

- (7) electric log (yes or no)

(organization running log)

- (8) how well bottom plugged sand  
stark

DRILLERS REMARKS: Very Good  
well

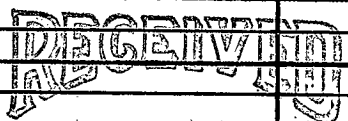


DEC 11 1981

Department of Natural Resources  
Bureau of Land & Water Resources

If well telescopes please sketch and show depths.

GROUND LEVEL

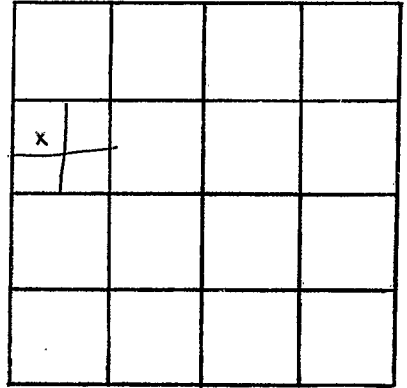

SECTION 17

Please indicate well location X.

ADDITIONAL INFORMATION

If more than one screen,  
show locations of each on sketch.