

MISSISSIPPI DEPARTMENT OF ENVIRONMENTAL QUALITY
Bureau of Land and Water Resources

P. O. Box 10631
Jackson, MS 39289-0631
WATER WELL DRILLERS LOG

COUNTY WELL LOCATED <i>Marion</i>	
WELL NUMBER <i>N 2665</i>	CODED
DATE WELL COMPLETED <i>8-15-92</i>	

PERMIT NUMBER
NAME OF DRILLING FIRM <i>Boems Water Well</i>

NAME & MAILING ADDRESS OF LANDOWNER <i>Morphis Bro Inc.</i>			
<i>P.O. Box 169 (Hwy 35 Columbia)</i>			
<i>Trout Lw 71371</i>			
WELL LOCATION:	SEC	TOWNSHIP	RANGE
	<i>12</i>	<i>2</i>	<i>N 13 E</i>
DISTANCE	DIRECTION	NEAREST TOWN	
<i>7</i> Miles	<i>SE</i>	of <i>Columbia</i>	
OTHER LANDMARK			
WELL PURPOSE: Home, Irrigation, Municipal, Industrial, Fish Pond, etc. <i>Oil field</i>			

PUMP DATA		
PUMP TYPE (Circle One): Submersible, Turbine, Jet, Flowing Well, Other (Describe) _____		
POWER TYPE (Circle One): Electric, Tractor, Diesel, Gasoline, Butane, Other (Describe) _____ H/P _____		
Pump Capacity (GPM)	No. of Stages	Setting Depth FT.
PUMP TEST		
Well yielded _____ GPM with a drawdown of _____ ft. after _____ hours of pumping		

WELL DATA		
Well Depth <i>100ft</i>	Casing Diameter (In.) <i>4"</i>	Casing Length (Ft.) <i>80</i>
Type of Casing <i>sch 40</i>	Hole Depth <i>100</i>	Depth to Static Water Level
TYPE OF COMPLETION: (Circle One or More): <input checked="" type="checkbox"/> Gravel Packed, <input type="checkbox"/> Underreamed, <input type="checkbox"/> Telescoped, <input type="checkbox"/> Natural Development, <input type="checkbox"/> Open Hole, <input type="checkbox"/> Other		
Top of Lap Pipe or Reduction in Casing FEET <input type="checkbox"/> IF TELESCOPED OR MORE THAN ONE SCREEN: USE BACK PAGE		

LOG DATA	
TYPE OF LOG RUN (Circle One): No Log Run, Electric, Gamma Ray, Density, Sonic, Neutron, Other (Describe) _____	
Name of Organization Running Log	

SCREEN DATA		
Diameter - Inches <i>4</i>	Length - Feet <i>20</i>	Slot Size - Inches <i># 10</i>
Screen Type <i>sch 40</i>	Depth to Bottom - Feet	


GEOLOGIC DATA (Office Use Only)			
Surface Elev.	Geologic Unit	Unit Thickness	Depth to Top
Subs. SWL	Date	Analysis	Aquifer Test
Driller's Remarks <i>Drilled + set casing</i>			

DESCRIPTION OF FORMATIONS ENCOUNTERED	FROM	TO
<i>CLAY</i>	<i>0</i>	<i>15</i>
<i>GRAVEL</i>	<i>15</i>	<i>100</i>

FORMATIONS (Continued)	FROM	TO
RECEIVED		
<i>JAN 07 1993</i>		
Dept. of Environmental Quality Bureau of Land & Water Resources		
IF MORE SPACE IS NEEDED, USE BACK		

If well telescopes please
sketch and show depths.

GROUND LEVEL

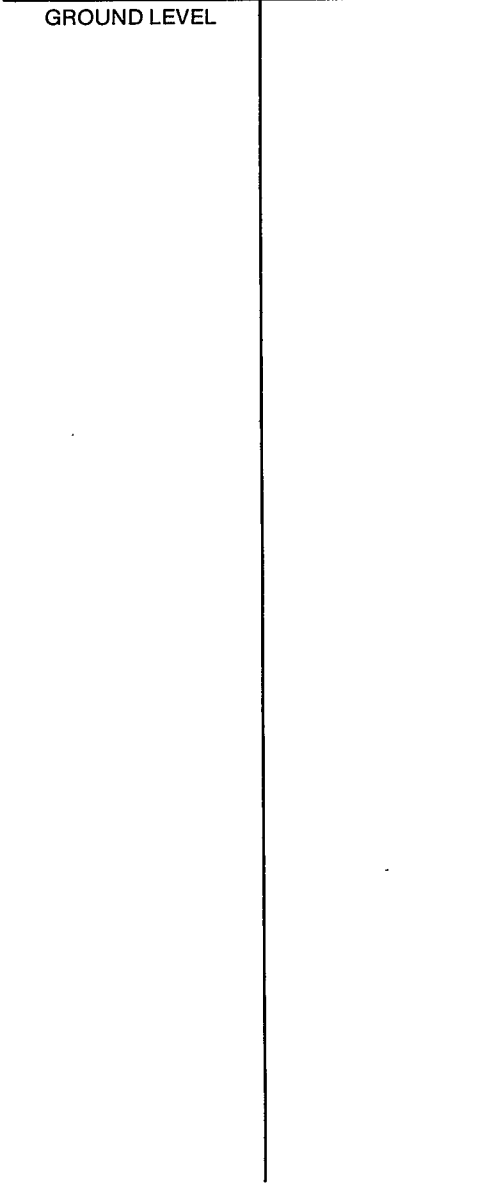

If more than one screen,
show location of each on sketch.

SECTION _____

Please indicate well location X.

ADDITIONAL INFORMATION

