

MISSISSIPPI DEPARTMENT OF ENVIRONMENTAL QUALITY

Office of Land and Water Resources

P. O. Box 10631
Jackson, MS 39289-0631

WATER WELL DRILLERS LOG

COUNTY WELL LOCATED <i>MAZION</i>	
WELL NUMBER <i>N 2067</i>	CODED
DATE WELL COMPLETED <i>9-4-92</i>	

PERMIT NUMBER <i>0-402</i>
NAME OF DRILLING FIRM <i>Tom Griffiths</i>
<i>Water Well</i>

NAME & MAILING ADDRESS OF LANDOWNER <i>Donald Forbes</i>			
<i>Forbes Rd</i>			
<i>Sandy Hook MS</i>			
WELL LOCATION:	SEC	TOWNSHIP	RANGE
	<i>2</i>	<i>1 N S</i>	<i>13 E W</i>
DISTANCE	DIRECTION	NEAREST TOWN	
<i>10</i> Miles	<i>S</i>	of <i>Foxworth</i>	
OTHER LANDMARK			
WELL PURPOSE: Home, Irrigation, Municipal, Industrial, Fish Pond, etc. <i>Home</i>			

PUMP DATA		
PUMP TYPE (Circle One): <input checked="" type="checkbox"/> Submersible, Turbine, Jet, Flowing Well, Other (Describe) _____		
POWER TYPE (Circle One): <input checked="" type="checkbox"/> Electric, Tractor, Diesel, Gasoline, Butane, Other (Describe) _____ H/P _____		
Pump Capacity (GPM) <i>10</i>	No. of Stages	Setting Depth FT.
PUMP TEST		
Well yielded _____ GPM with a drawdown of _____ ft. after _____ hours of pumping		

WELL DATA		
Well Depth <i>155</i>	Casing Diameter (In.) <i>4</i>	Casing Length (Ft.) <i>135</i>
Type of Casing <i>PVC</i>	Hole Depth <i>155</i>	Depth to Static Water Level <i>100</i>

LOG DATA	
TYPE OF LOG RUN (Circle One): No Log Run, Electric, Gamma Ray, Density, Sonic, Neutron, Other (Describe) _____	
Name of Organization Running Log	


TYPE OF COMPLETION: (Circle One or More):
 Gravel Packed, Underreamed, Telescoped,
 Natural Development, Open Hole, Other
 (Describe) _____

GEOLOGIC DATA (Office Use Only)			
Surface Elev.	Geologic Unit	Unit Thickness	Depth to Top
Subs. SWL	Date	Analysis	Aquifer Test

WELL GROUTED TO A DEPTH OF _____ FEET
 Type Grout (circle one): Cement, Bentonite, or Mix

Driller's Remarks


SCREEN DATA		
Diameter - Inches <i>4</i>	Length - Feet <i>20</i>	Slot Size - Inches <i>10/10</i>
Screen Type <i>PVC</i>	Depth to Bottom - Feet <i>0</i>	

DESCRIPTION OF FORMATIONS ENCOUNTERED	FROM	TO	FORMATIONS (Continued)	FROM	TO
<i>Clay GRAVEL</i>	<i>0</i>	<i>60</i>	 DEC 30 1992 Dept. of Environmental Quality Bureau of Land & Water Resources		
<i>Soft Clay</i>	<i>60</i>	<i>100</i>			
<i>SAND & Pea GRAVEL</i>	<i>100</i>	<i>154</i>			
<i>Limestone</i>	<i>154</i>	<i>155</i>			

IF MORE SPACE IS NEEDED, USE BACK

If well telescopes please sketch and show depths.

GROUND LEVEL

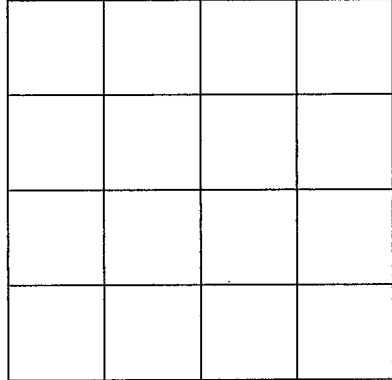

SECTION _____

Please indicate well location X.

ADDITIONAL INFORMATION

If more than one screen,
show location of each on sketch.