

MISSISSIPPI DEPARTMENT OF ENVIRONMENTAL QUALITY

Office of Land and Water Resources

P. O. Box 10631
Jackson, MS 39289-0631
WATER WELL DRILLERS LOG

COUNTY WELL LOCATED Marion	
WELL NUMBER N 2069	CODED
DATE WELL COMPLETED 12-12-92	

PERMIT NUMBER 0-402
NAME OF DRILLING FIRM Tom Griffith
Water Well Inc.

NAME & MAILING ADDRESS OF LANDOWNER Herbert Turnage BOX 139 Turnage Lane Foxworth Miss. 39483		
WELL LOCATION: .SEC	TOWNSHIP	RANGE
12	2	N 12 W
DISTANCE	DIRECTION	NEAREST TOWN
10 Miles	S. W.	of Foxworth
OTHER LANDMARK		
WELL PURPOSE: Home, Irrigation, Municipal, Industrial, Fish Pond, etc. Home		

PUMP DATA		
PUMP TYPE (Circle One): Submersible, Turbine, Jet Flowing Well, Other (Describe)		
POWER TYPE (Circle One): Electric , Tractor, Diesel, Gasoline, Butane, Other (Describe) H/P 1		
Pump Capacity (GPM) 8	No. of Stages	Setting Depth 100 FT.
PUMP TEST		
Well yielded 8 GPM with a drawdown of _____ ft. after _____ hours of pumping		

Well Depth 145 FT	Casing Diameter (In.) 2 in	Casing Length (FL.) 125
Type of Casing PVC	Hole Depth 145 FT	Depth to Static Water Level 80

LOG DATA	
TYPE OF LOG RUN (Circle One): Electric, Gamma Ray, Density, Sonic, Neutron, Other (Describe) No Log Run	
Name of Organization Running Log	

TYPE OF COMPLETION: (Circle One or More):
Gravel Packed Underreamed, Telescoped,
Natural Development, Open Hole, Other

GEOLOGIC DATA (Office Use Only)			
Surface Elev.	Geologic Unit	Unit Thickness	Depth to Top
Subs. SWL	Date	Analysis	Aquifer Test

WELL GROUTED TO A DEPTH OF **15** FEET
Type Grout (circle one): **Cement**, Bentonite, or Mix

Driller's Remarks			


SCREEN DATA		
Diameter - Inches 2 in	Length - Feet 20	Slot Size - Inches 010
Screen Type PVC SLOT	Depth to Bottom - Feet 125-145	

DESCRIPTION OF FORMATIONS ENCOUNTERED	FROM	TO
Top Soil	0	3
Clay	3	50
Sand and Gravel	50	145

FORMATIONS (Continued)	FROM	TO
RECEIVED		
SEP 17 1993		
Dept. of Environmental Quality Office of Land & Water Resources		
IF MORE SPACE IS NEEDED, USE BACK		

If well telescopes please sketch and show depths.

GROUND LEVEL

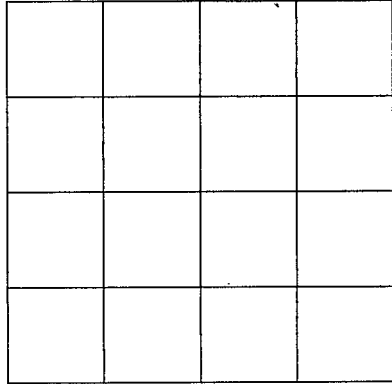

SECTION _____
Please indicate well location X.

ADDITIONAL INFORMATION

If more than one screen,
show location of each on sketch.