

MARION
N 2072

MISSISSIPPI
BOARD OF WATER COMMISSIONERS
416 North State Street
Jackson, Mississippi 39201

WATER WELL DRILLERS LOG

march 4 19 94 FitzGERMID Well Service MARION
date well completed firm name county well located

LANDOWNER:
AUSTIN WALSH
R.R. Kokomo
(mailing address)

description of formations encountered	from	to
<u>Pool Clear</u>	<u>0</u>	<u>20</u>
<u>Pool Layer</u>	<u>20</u>	<u>136</u>
<u>Coarse Sandstone</u>	<u>136</u>	<u>150</u>

WELL LOCATION:
sec. 1 T 2 N R 12 E
S W
1 miles ESE of Kokomo
(distance) (direction) (nearest town)

WELL PURPOSE: Pool Water House
(home, irrigation, municipal, industrial)

- WELL COMPLETION DATA:
- (1) diameter (inches) 4
 - (2) total depth (feet) 150
 - (3) static water level (feet) 98 below above top of ground.
 - (4) casing 20C 140
(material) (depth)
4 if telescope see back.
(size)
 - (5) screen 10 140
(length) (depth to top)
4 20C
(size) (material)
 - (6) pump 1 20
(HP) (yield gpm)
elec
(type power)
 - (7) electric log no
(yes or no)
(organization running log)
 - (8) how well bottom plugged Seal shell

RECEIVED


JUN 17 1994

Dept. of Environmental Quality
Office of Land & Water Resources

DRILLERS REMARKS:

If well telescopes please sketch and show depths.

GROUND LEVEL

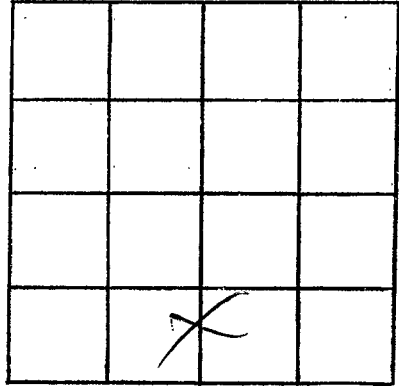

SECTION /

Please indicate well location X.

ADDITIONAL INFORMATION

If more than one screen,
show locations of each on sketch.