

**MISSISSIPPI DEPARTMENT OF ENVIRONMENTAL QUALITY**  
Office of Land and Water Resources

P. O. Box 10631  
Jackson, MS 39289-0631  
**WATER WELL DRILLERS LOG**

COUNTY WELL LOCATED <u>Marion</u>
WELL NUMBER (CODED) <u>N 2078</u>
DATE WELL COMPLETED <u>8-22-95</u>

PERMIT NUMBER
NAME OF DRILLING FIRM <u>Boards Water Well</u>

NAME & MAILING ADDRESS OF LANDOWNER <u>Jerry Pittman</u> <u>217 10 mile Creek Rd.</u> <u>Foxworth MS</u>			
WELL LOCATION:	SEC	TOWNSHIP	RANGE
	<u>10</u>	<u>2</u> <sup>N</sup> / <sub>S</sub>	<u>13</u> <sup>E</sup> / <sub>W</sub>
DISTANCE	DIRECTION	NEAREST TOWN	
_____ Miles	_____ of _____		
OTHER LANDMARK			
WELL PURPOSE (Circle one) <u>Home</u> , Irrigation, Municipal, Industrial, Fish Pond, etc.			

<b>PUMP DATA</b>		
PUMP TYPE (Circle One): <u>Submersible</u> , Turbine, Jet, Flowing Well, Other (Describe) _____		
POWER TYPE (Circle One): <u>Electric</u> , Tractor, Diesel, Gasoline, Butane, Other (Describe) _____ H/P <u>1</u>		
Pump Capacity (GPM)	No. of Stages	Setting Depth _____ FT.
PUMP TEST		
Well yielded _____ GPM with a drawdown of _____ ft. after _____ hours of pumping		

<b>WELL DATA</b>		
Well Depth <u>160</u>	Casing Diameter (In.) <u>4</u>	Casing Length (Ft.) <u>140</u>
Type of Casing <u>gh 40</u>	Hole Depth <u>160</u>	Depth to Static Water Level

<b>LOG DATA</b>	
TYPE OF LOG RUN (Circle One): <u>Electric</u> , Gamma Ray, Density, Sonic, Neutron, Other (Describe) _____	
Name of Organization Running Log	


TYPE OF COMPLETION: (Circle One or More):  
Gravel Packed, Underreamed, Telescoped,  
Natural Development, Open Hole, Other

<b>GEOLOGIC DATA (Office Use Only)</b>			
Surface Elev.	Geologic Unit	Unit Thickness	Depth to Top
Subs. SWL	Date	Analysis	Aquifer Test

WELL GROUTED TO A DEPTH OF 5 FEET  
Type Grout (circle one): Cement Bentonite, or Mix

Driller's Remarks	
Top of Lap Pipe or Reduction in Casing _____ FEET	
IF TELESCOPED OR MORE THAN ONE SCREEN: USE BACK PAGE	


<b>SCREEN DATA</b>		
Diameter - Inches <u>4</u>	Length - Feet <u>20</u>	Slot Size - Inches <u>#8</u>
Screen Type <u>sch 40</u>		Depth to Bottom - Feet

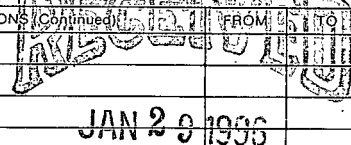DESCRIPTION OF FORMATIONS ENCOUNTERED	FROM	TO	FORMATIONS (Continued) FROM 151 TO
<u>Clay</u>	<u>0</u>	<u>60</u>	 <u>JAN 29 1996</u>
<u>Sand &amp; pea gravel</u>	<u>60</u>	<u>160</u>	

Dept. of Environmental Quality  
Office of Land & Water Resources

If well telescopes please sketch and show depths.

GROUND LEVEL

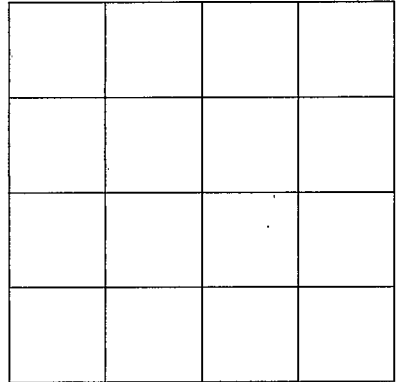

SECTION \_\_\_\_\_

Please indicate well location X.

ADDITIONAL INFORMATION

---

---

If more than one screen, show location of each on sketch.