

MISSISSIPPI DEPARTMENT OF ENVIRONMENTAL QUALITY

Office of Land and Water Resources

P. O. Box 10631
Jackson, MS 39289-0631
WATER WELL DRILLERS LOG

| | |
|---------------------------------------|-------|
| COUNTY WELL LOCATED <i>Marion</i> | |
| WELL NUMBER <i>N 2081</i> | CODED |
| DATE WELL COMPLETED <i>4-19-96</i> | |

| |
|--|
| PERMIT NUMBER <i>0-586</i> |
| NAME OF DRILLING FIRM <i>James Wells Water Well Ser</i> |

| | | | |
|---|--------------------------|------------------------------------|----------------------|
| NAME & MAILING ADDRESS OF LANDOWNER <i>Trey Pounds</i> <i>55 Geslie Pounds Lane</i> <i>Foxworth, Miss 39483</i> | | | |
| WELL LOCATION: | SEC <i>9</i> | TOWNSHIP <i>2 N</i> | RANGE <i>13 E</i> |
| DISTANCE <i>8</i> Miles | DIRECTION <i>S.W.</i> | NEAREST TOWN <i>of Foxworth</i> | |
| OTHER LANDMARK | | | |
| WELL PURPOSE <input checked="" type="checkbox"/> Home, <input type="checkbox"/> Irrigation, <input type="checkbox"/> Municipal, <input type="checkbox"/> Industrial, <input type="checkbox"/> Fish Pond, etc. | | | |

| | | | |
|---|---------------|---------------|-----|
| PUMP DATA | | | |
| PUMP TYPE (Circle One): <input checked="" type="radio"/> Submersible <input type="radio"/> Turbine, <input type="radio"/> Jet <input type="radio"/> Flowing Well, Other (Describe) _____ | | | |
| POWER TYPE (Circle One): <input checked="" type="radio"/> Electric <input type="radio"/> Tractor, <input type="radio"/> Diesel, <input type="radio"/> Gasoline, <input type="radio"/> Butane, Other (Describe) _____ H/P <i>1</i> | | | |
| Pump Capacity (GPM) | No. of Stages | Setting Depth | FT. |
| PUMP TEST | | | |
| Well yielded <i>12</i> GPM with a drawdown of _____ ft. after _____ hours of pumping | | | |

| | | |
|------------------------------|--------------------------------------|--|
| WELL DATA | | |
| Well Depth <i>80</i> | Casing Diameter (In.) <i>4 in</i> | Casing Length (Ft.) <i>70</i> |
| Type of Casing <i>PVC</i> | Hole Depth <i>80 FT</i> | Depth to Static Water Level <i>70</i> |

| | |
|--|--|
| LOG DATA | |
| TYPE OF LOG RUN (Circle One): <input type="radio"/> No Log Run, <input type="radio"/> Electric, <input type="radio"/> Gamma Ray, <input type="radio"/> Density, <input type="radio"/> Sonic, <input type="radio"/> Neutron, Other (Describe) _____ | |
| Name of Organization Running Log | |

TYPE OF COMPLETION: (Circle One or More):
 Gravel Packed, Underreamed, Telescoped,
 Natural Development, Open Hole, Other
(Describe) _____

| GEOLOGIC DATA (Office Use Only) | | | |
|---------------------------------|---------------|----------------|--------------|
| Surface Elev. | Geologic Unit | Unit Thickness | Depth to Top |
| Subs. SWL | Date | Analysis | Aquifer Test |

WELL GROUTED TO A DEPTH OF _____ FEET
Type Grout (circle one): Cement, Bentonite, or Mix

| | |
|--|--|
| Driller's Remarks | |
| Top of Lap Pipe or Reduction in Casing | |
| FEET | IF TELESCOPED OR MORE THAN ONE SCREEN: USE BACK PAGE |


| | | |
|----------------------------------|--|----------------------------------|
| SCREEN DATA | | |
| Diameter - Inches <i>4 in</i> | Length - Feet <i>10</i> | Slot Size - Inches <i>008</i> |
| Screen Type <i>PVC</i> | Depth to Bottom - Feet <i>70-80</i> | |

| DESCRIPTION OF FORMATIONS ENCOUNTERED | FROM | TO |
|---------------------------------------|-----------|-----------|
| <i>Top 3 oil</i> | <i>0</i> | <i>2</i> |
| <i>clay</i> | <i>2</i> | <i>50</i> |
| <i>sand</i> | <i>50</i> | <i>80</i> |
| | | |
| | | |
| | |
|--|--|
| RECEIVED | |
| JUN 18 1996 | |
| Dept. of Environmental Quality Office of Land & Water Resources | |
| IF MORE SPACE IS NEEDED, USE BACK | |

If well telescopes please
sketch and show depths.

GROUND LEVEL

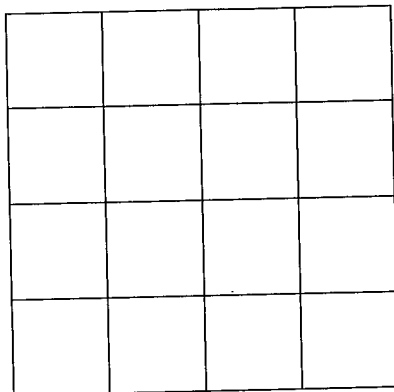

SECTION _____

Please indicate well location X.

ADDITIONAL INFORMATION

If more than one screen,
show location of each on sketch.