



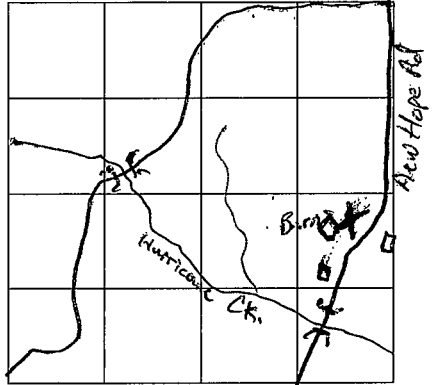

If well telescopes please sketch and show depths.

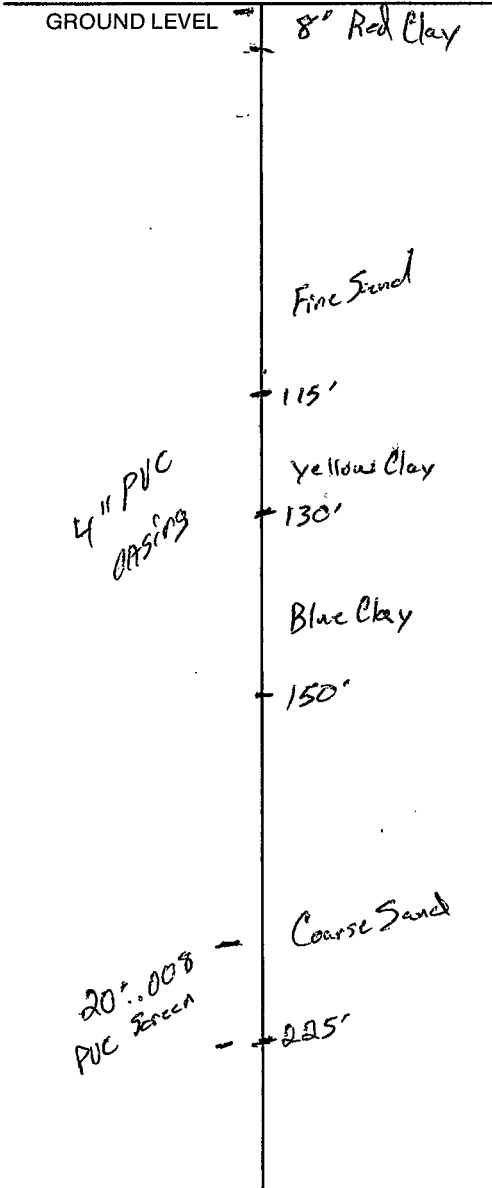

SECTION 32

Please indicate well location X.

ADDITIONAL INFORMATION

Well is next to a barn on top of Hill in the curve.

If more than one screen, show location of each on sketch.