

MARION
 10-3-78

MISSISSIPPI
 BOARD OF WATER COMMISSIONERS
 416 North State Street
 Jackson, Mississippi 39201

WATER WELL DRILLERS LOG

10/3 19 78 Hollister Wells Marion
 date well completed firm name county well located

LANDOWNER: Mrs. T. James
 RT1
 Sandy Hook (mailing address)

description of formations encountered	from	to
CHALK	0	20
pea gravel	20	65

WELL LOCATION:
 sec. 30 T. 18 N. R. 18 E. W. 1
 4 miles N of Sandy Hook
 (distance) (direction) (nearest town)

WELL PURPOSE: Home
 (home, irrigation, municipal, industrial)

WELL COMPLETION DATA:
 (1) diameter (inches) 2"
 (2) total depth (feet) 65
 (3) static water level (feet) 10 below top of ground.
 (4) casing PVC, 55 (depth)
 (size) if telescope see back.
 (5) screen 5ft., 60 (depth to top)
 (size) (material)
 (6) pump 1/2 (HP) 12 (yield gpm)
 elect (type power)
 (7) electric log (yes or no)
 (organization running log)
 (8) how well bottom plugged sand shark


DRILLERS REMARKS: Very good

RECEIVED
 OCT 12 1978

MISS. BD. OF WATER COMMISSIONERS

If well telescopes please sketch and show depths.

GROUND LEVEL

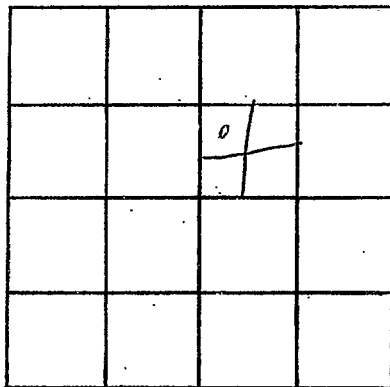

SECTION 30

Please indicate well location X.

ADDITIONAL INFORMATION

If more than one screen,
show locations of each on sketch.