

MISSISSIPPI
BOARD OF WATER COMMISSIONERS
416 North State Street
Jackson, Mississippi 39201

CODED

WATER WELL DRILLERS LOG

Marion
Ø 10
11-24-69

11/24 1969 Dean Krimer Marion
date well completed firm name county well located

LANDOWNER:
Mr. Lee Kumbler
Route 5 Columbia, Miss.
(mailing address)

description of formations encountered	from	to
<u>Top soil</u>	<u>0-1</u>	
<u>red sand</u>	<u>1-12</u>	
<u>Chalk</u>	<u>12-28</u>	
<u>Water sand</u>	<u>28-43</u>	

WELL LOCATION:
sec. 13 T. 2 N. R. 14 E.
S. W.
_____ miles of Columbia
(distance) (direction) (nearest town)

WELL PURPOSE:
(home, irrigation, municipal, industrial)

WELL COMPLETION DATA:

(1) diameter (inches) 2"

(2) total depth (feet) 43'

(3) static water level (feet) 25 below
top of ground.

(4) casing Plastic, 38'
(material) (depth)
_____ if telescope see back.
(size)

(5) screen 5', 38'
(length) (depth to top)
2x5', Plastic
(size) (material)

(6) pump _____ (HP) _____ (yield gpm)
Used old pump
(type power)

(7) electric log No
(yes or no)

(organization running log)

(8) how well bottom plugged _____

CODED


MAR 18 1970

MISS. BD. OF
WATER COMM.

DRILLERS REMARKS:

If well telescopes please sketch and show depths.

GROUND LEVEL

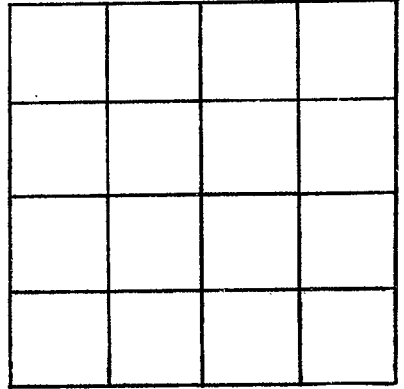

SECTION _____

Please indicate well location X.

ADDITIONAL INFORMATION

If more than one screen, show locations of each on sketch.