

MARION
 #11
 8-70

MISSISSIPPI
 BOARD OF WATER COMMISSIONERS
 416 North State Street
 Jackson, Mississippi 39201

CODED

WATER WELL DRILLERS LOG

August 1970 E. B. SHEPARD MARION
 date well completed firm name county well located

LANDOWNER:
 MT. CARMEL CHURCH
 FOXWORTH, MISS.
 (mailing address)

description of formations encountered
 SAND & GRAVEL
 CLAY
 GRAVEL & SAND
 from to
 0 40
 40 102

WELL LOCATION:
 sec 24 T 2 N R 18 E
 S W
 8 miles S of FOXWORTH
 (distance) (direction) (nearest town)

WELL PURPOSE: CHURCH
 (home, irrigation, municipal, industrial)

CODED

- WELL COMPLETION DATA:
- (1) diameter (inches) 2"
 - (2) total depth (feet) 102
 - (3) static water level (feet) 68 below above top of ground.
 - (4) casing PL. 99' (material) (depth)
 2" (size) if telescope see back.
 - (5) screen 3' (length) (depth to top)
 2" (size) S.S. (material)
 - (6) pump 3/4 (HP) 7 (yield gpm)
 E (type power)
 - (7) electric log (yes or no)
 - (organization running log)
 - (8) how well bottom plugged BWV


OCT 13 1970

MISS. BD. OF
 WATER
 COMM.

DRILLERS REMARKS:

If well telescopes please sketch and show depths.

GROUND LEVEL

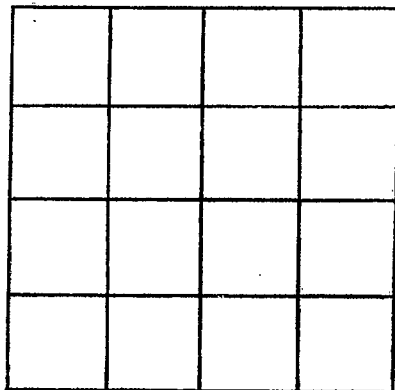

SECTION _____

Please indicate well location X.

ADDITIONAL INFORMATION

If more than one screen, show locations of each on sketch.