

MARION  
 12  
 10/73

MISSISSIPPI  
 BOARD OF WATER COMMISSIONERS  
 416 North State Street  
 Jackson, Mississippi 39201

CODED

WATER WELL DRILLERS LOG

Oct. 23 1973 E. B. Sheppard Marion  
 date well completed firm name county well located


LANDOWNER:	description of formations encountered	from	to
Ray Mc Murry Sandy Hook (mailing address)	SANDY GR.	0	30
	CLAY GRAY	30	60
	FINE SAND	60	100
	COARSE PEA GR.	100	125
WELL LOCATION: sec 31 T 20 N R 14 E 9 miles S of Joplin (distance) (direction) (nearest town)			
WELL PURPOSE: (home) irrigation, municipal, industrial			
WELL COMPLETION DATA: (1) diameter (inches) 4" (2) total depth (feet) 125' (3) static water level (feet) 25 below top of ground. (4) casing pl. 115' (material) (depth) 4" (size) if telescope see back. (5) screen 10' (length) (depth to top) 4" (size) pl. (material) (6) pump 2 (HP) 25 (yield gpm) E (type power) (7) electric log (yes or no) (organization running log) (8) how well bottom plugged BWV			
DRILLERS REMARKS:			

CODED

MAY 10 1974  
 MISS. BOARD OF WATER COMMISSIONERS

If well telescopes please sketch and show depths.

GROUND LEVEL

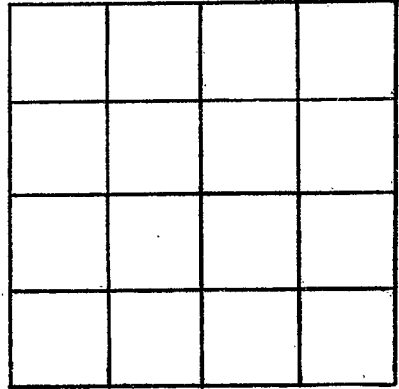

SECTION \_\_\_\_\_

Please indicate well location X.

ADDITIONAL INFORMATION

If more than one screen, show locations of each on sketch.