

MARION
 Ø 13
 5/74

MISSISSIPPI
 BOARD OF WATER COMMISSIONERS
 416 North State Street
 Jackson, Mississippi 39201

CODED

WATER WELL DRILLERS LOG

May 1974 E.B. Sheppard Marion
 date well completed firm name county well located

LANDOWNER:

James Jefferson
 Rt. 5 - Columbia, Ms.
 (mailing address)

description of formations encountered

SAND & GR. 0 to 65'

from to

WELL LOCATION:

sec 26 T 2 N R 18 W
 S
 10 miles SSE Columbia
 (distance) (direction) (nearest town)

CODED

WELL PURPOSE:

(home irrigation, municipal, industrial)


WELL COMPLETION DATA:

- (1) diameter (inches) 2"
- (2) total depth (feet) 65'
- (3) static water level (feet) 8' below top of ground.
- (4) casing (material) pl. (depth) 60'
- 2" If telescope see back.
 (size)
- (5) screen 5' (length) (depth to top)
- 2" pl. (size) (material)
- (6) pump 1/3 (HP) 8 (yield gpm)
- E (type power)
- (7) electric log (yes or no)

(organization running log)

(8) how well bottom plugged BWW

DRILLERS REMARKS:

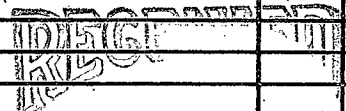


APR - 1 1974

MISS. BD. OF WATER

If well telescopes please sketch and show depths.

GROUND LEVEL

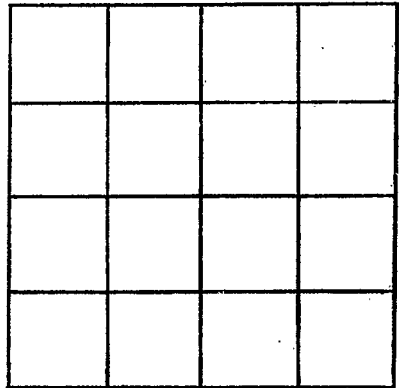

SECTION _____

Please indicate well location X.

ADDITIONAL INFORMATION

If more than one screen, show locations of each on sketch.