

MARION
 Ø 16
 10/2/78

MISSISSIPPI
 BOARD OF WATER COMMISSIONERS
 416 North State Street
 Jackson, Mississippi 39201

CODED

WATER WELL DRILLERS LOG

10/2/78 Griner Drilling Service Marion
 date well completed firm name county well located

LANDOWNER:
 Exxon Oil Company
 P.O. Box 53226
 New Orleans, LA.
 (mailing address)

description of formations encountered	from	to
Gravel	0	21
Gravel	21	42
Gravel	42	63
Gravel	63	84
Gravel	84	105
Gravel	105	126
CLAY	126	147

WELL LOCATION:

sec. 19 T 20 S R 14 E
 8 miles South of Columbia
 (distance) (direction) (nearest town)
 on Hwy 35

WELL PURPOSE: oil field supply
 (home, irrigation, municipal, industrial)

WELL COMPLETION DATA:

- (1) diameter (inches) 4"
- (2) total depth (feet) 147'
- (3) static water level (feet) 10' below top of ground.
- (4) casing steel 126' (material) (depth)
 4" (size) if telescope see back.
- (5) screen 21' 105' (length) (depth to top)
 4" perforated (size) (material)
- (6) pump — 100 (HP) (yield gpm)
 AC (type power)
- (7) electric log — (yes or no)
 (organization running log)

2225'S + 425' W
 of NE cor.

(8) how well bottom plugged orange
 peel


DRILLERS REMARKS:

RECEIVED
 OCT 19 1978

MISS. BR. OF WATER COMMISSIONERS

If well telescopes please sketch and show depths.

GROUND LEVEL

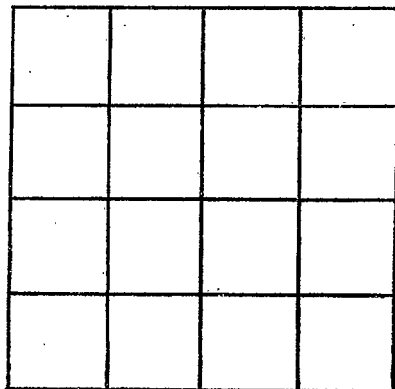

SECTION _____

Please indicate well location X.

ADDITIONAL INFORMATION

If more than one screen, show locations of each on sketch.