

MARION  
 Ø 17  
 2.14-79

MISSISSIPPI  
 BOARD OF WATER COMMISSIONERS  
 416 North State Street  
 Jackson, Mississippi 39201

WATER WELL DRILLERS LOG

2-14-79 Griner Drilling Marion  
 date well completed firm name county well located

LANDOWNER:	description of formations encountered	from	to
EXXON Oil Co., W.S.A. P.O. Box 2180 Houston, TX 77001 (mailing address)	Sand + gravel Chalk Sand	0 120 574	120 574 609
WELL LOCATION: 2225' S 6423' W. sec. 19 T 20 N R 14 E of Hwy 35 S W Nekor 5 miles South of Columbia (distance) (direction) (nearest town)			
WELL PURPOSE: oil field supply (home, irrigation, municipal, industrial)			
WELL COMPLETION DATA: 3" Waterwell			
(1) diameter (inches) 609'			
(2) total depth (feet)			
(3) static water level (feet) 100' <sup>below</sup> above top of ground			
(4) casing steel 609' (material) (depth) 3" if telescope see back. (size)			
(5) screen open end (length) (depth to top) (size) (material)			
(6) pump AC 75-80 (HP) (yield gpm) (type power)			
(7) electric log (yes or no)			
(organization running log)			
(8) how well bottom plugged orange peel			
DRILLERS REMARKS:			


MISSISSIPPI BOARD OF WATER COMMISSIONERS

FEB 26 1979

RECEIVED

If well telescopes please  
sketch and show depths.

GROUND LEVEL

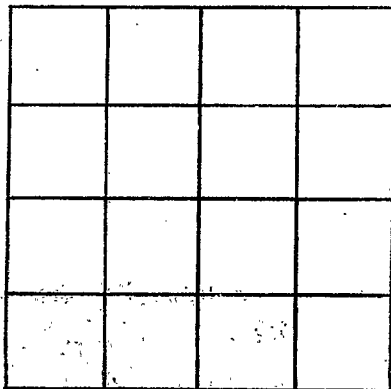

SECTION \_\_\_\_\_

Please indicate well location X.

ADDITIONAL INFORMATION

If more than one screen,  
show locations of each on sketch.