

MARION
 Ø 18
 9-7-79

MISSISSIPPI
 BOARD OF WATER COMMISSIONERS CODED
 416 North State Street
 Jackson, Mississippi 39201

WATER WELL DRILLERS LOG

9-7-79 Griner Drilling Marion
 date well completed firm name county well located

LANDOWNER: Exxon Oil Company
 P.O. Box 53226
 New Orleans, La.
 (mailing address)

description of formations encountered	from	to
Clay	0	5
sand + gravel	5	75
clay-breaker sand	75	441
clay + sand	441	510
sand + pe + gravel	510	640
clay, sand, & gravel	640	658

WELL LOCATION: 1500' S + 1659' E
 sec. 17 T. 20 N R. 14 E of SW/CO
 5 miles SW of Columbia
 (distance) (direction) (nearest town)

WELL PURPOSE: oil field supply
 (home, irrigation, municipal, industrial)

- WELL COMPLETION DATA:
- (1) diameter (inches) 4"
 - (2) total depth (feet) 650'
 - (3) static water level (feet) flow below top of ground. well above
 - (4) casing steel 636' (material) (depth)
 4" (size) if telescope see back.
 - (5) screen 42' 594' (length) (depth to top)
 4" perforated (size) (material)
 - (6) pump — 150 (HP) (yield gpm)
 AC (type power)
 - (7) electric log — (yes or no)
 (organization running log)
 - (8) how well bottom plugged orange peel

DRILLERS REMARKS:

CODED


DEPT. OF NATURAL RESOURCES
 BUREAU OF LAND & WATER RESOURCES

OCT 26 1979

RECEIVED

If well telescopes please sketch and show depths.

GROUND LEVEL

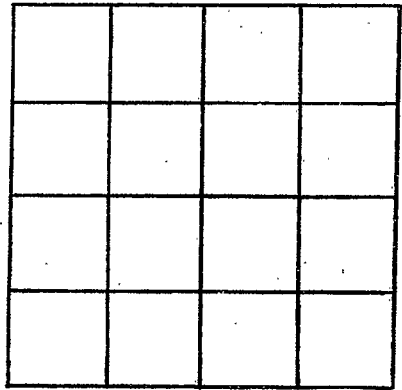

SECTION _____

Please indicate well location X.

ADDITIONAL INFORMATION

If more than one screen, show locations of each on sketch.