

MISSISSIPPI DEPARTMENT OF NATURAL RESOURCES

Bureau of Land and Water Resources

Southport Mall

P.O. Box 10631

Jackson, Mississippi 39209

CODED

WATER WELL DRILLERS LOG

MARION
Φ 20
6-4-81

*Grimes Drilling Service, Inc*

*Marion*

6-4-81 date well completed

Grimes Drilling Service, Inc firm name

Marion county well located

LANDOWNER:  
*Sonat Exploration*  
*P.O. Box 1513*  
*Houston, Texas*  
(mailing address)

description of formations encountered

from

to

*clay, sand, & gravel* 0 203

WELL LOCATION: *1500' N + 1500' W*  
*Sec. 21 T. 2 S. R. 14 E of*  
*West Sandy Hook*  
*Field*  
(distance) (direction) (nearest town)

*clay, rock, & sand* 203 722

*sand* 722 800

WELL PURPOSE: *oil field*  
(home, irrigation, municipal, industrial, or supply)

WELL COMPLETION DATA:

- (1) diameter (inches) *4"*
- (2) total depth (feet) *800'*
- (3) static water level (feet) *flow* below above top of ground.
- (4) casing *steel 7 7/8"* (material) (depth)  
*4"* (size) if telescope see back.
- (5) screen *42'* (length) *735'* (depth to top)  
*4" perforated* (size) (material)
- (6) pump *90-100* (HP) (yield gpm)  
*ac* (type power)
- (7) electric log *—* (yes or no)

CODED




(organization running log)

(8) how well bottom plugged *orange*  
*peel*

DRILLERS REMARKS:

If well telescopes please  
sketch and show depths.

GROUND LEVEL

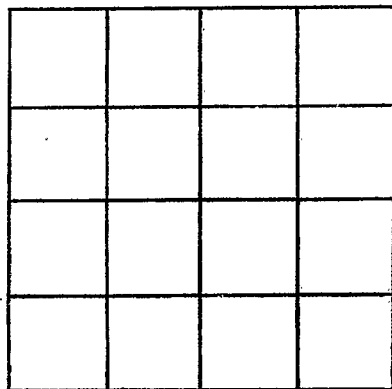

SECTION \_\_\_\_\_

Please indicate well location X.

ADDITIONAL INFORMATION

If more than one screen,  
show locations of each on sketch.