

MISSISSIPPI DEPARTMENT OF NATURAL RESOURCES

Bureau of Land and Water Resources

Southport Mall

P.O. Box 10631

Jackson, Mississippi 39209 **CODED**

WATER WELL DRILLERS LOG

MARION
Ø 21
6-6-81

date well completed


firm name

county well located

6-6-81 *Greene Drilling Service Inc* *Marion*

LANDOWNER:	description of formations encountered	from	to
EXXON Company U.S.A. P.O. Box 1337 Harvey, La 70059 (mailing address)	sand + gravel	0	126
	chalk	126	315
WELL LOCATION: 1590' N 4 31' D E sec 7 T 20 N R 14 E of Hub Field Hub Field (distance) miles (direction) of (nearest town)	shale	315	378
	chalk	378	525
WELL PURPOSE: oil field supply	sand	525	545
	sand + gravel	545	588
WELL COMPLETION DATA:	chalk	588	630
(1) diameter (inches) 4"			
(2) total depth (feet) 630'			
(3) static water level (feet) flow below top of ground.			
(4) casing steel 588' (material) (depth)			
4" (size) if telescope see back.			
(5) screen 42' 546' (length) (depth to top)			
4" perforated (size) (material)			
(6) pump — 100 (HP) (yield gpm)			
AC (type power)			
(7) electric log — (yes or no)			
(organization running log)			
(8) how well bottom plugged <i>range</i> <i>peel</i>			


CODED

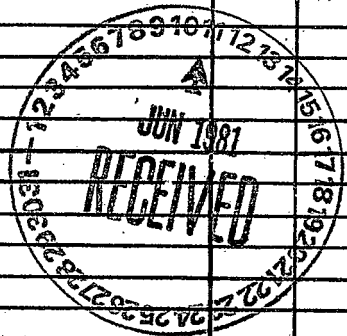

DRILLERS REMARKS:

If well telescopes please
sketch and show depths.

GROUND LEVEL

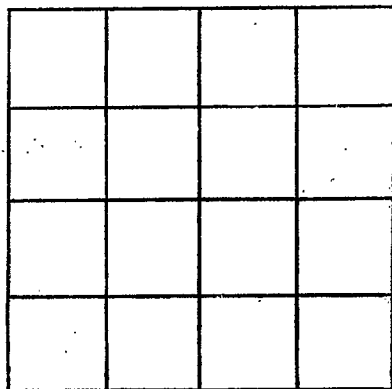

SECTION _____

Please indicate well location X.

ADDITIONAL INFORMATION

If more than one screen,
show locations of each on sketch.